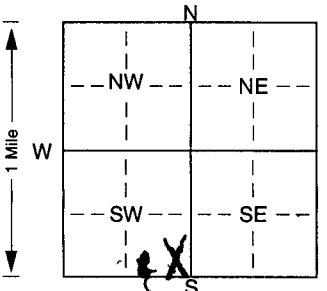


1 LOCATION OF WATER WELL: Fraction SE 1/4 SW 1/4 SW 1/4 Section Number 37 Township Number T 7 S Range Number R 37 EW
 County Sherman
 Distance and direction from nearest town or city street address of well if located within city?
11 miles west of Goodland - 8 miles north

2 WATER WELL OWNER: Sybil Bear
 RR#, St. Address, Box #: 2581 CR 3 Board of Agriculture, Division of Water Resources
 City, State, ZIP Code: Brewster, KS 67732 Application Number:

3 LOCATE WELL'S LOCATION WITH AN "X" IN SECTION BOX:

 4 DEPTH OF COMPLETED WELL: 305 ft. ELEVATION:
 Depth(s) Groundwater Encountered: 1 ft. 180 ft. 2. ft. 3. ft.
 WELL'S STATIC WATER LEVEL: 180 ft. below land surface measured on mo/day/yr 7-18-02
 Pump test data: Well water was ft. after hours pumping gpm
 Est. Yield gpm: Well water was ft. after hours pumping gpm
 Bore Hole Diameter: 8 in. to 305 ft., and in. to ft.
 WELL WATER TO BE USED AS:
 1 Domestic 3 Feedlot 6 Oil field water supply 9 Dewatering 12 Other (Specify below)
 2 Irrigation 4 Industrial 7 Domestic (lawn & garden) 10 Monitoring well
 Was a chemical/bacteriological sample submitted to Department? Yes. No. If yes, mo/day/yr sample submitted
 Water Well Disinfected? Yes No

5 TYPE OF BLANK CASING USED:
 1 Steel 3 RMP (SR) 6 Asbestos-Cement 9 Other (specify below) CASING JOINTS Glued Clamped
 2 PVC 4 ABS 7 Fiberglass Welded
 Blank casing diameter: 5 in. to 285 ft., Dia. in. to ft., Dia. in. to ft.
 Casing height above land surface: 12 in., weight 160 psi /ft. Wall thickness or gauge No. SAR 26

TYPE OF SCREEN OR PERFORATION MATERIAL:
 1 Steel 3 Stainless steel 5 Fiberglass 8 RMP (SR) 10 Asbestos-cement
 2 Brass 4 Galvanized steel 6 Concrete tile 9 ABS 12 None used (open hole)

SCREEN OR PERFORATION OPENINGS ARE:
 1 Continuous slot 3 Mill slot 5 Gauzed wrapped 8 Saw cut 11 None (open hole)
 2 Louvered shutter 4 Key punched 6 Wire wrapped 9 Drilled holes
 7 Torch cut 10 Other (specify) ft.

SCREEN-PERFORATED INTERVALS: From 285 ft. to 305 ft., From ft. to ft.
 From ft. to ft., From ft. to ft.
 GRAVEL PACK INTERVALS: From 180 ft. to 305 ft., From ft. to ft.
fine gravel silica sand From 180 ft. to 305 ft., From ft. to ft.

6 GROUT MATERIAL: Neat cement 2 Cement grout 3 Bentonite 4 Other
 Grout Intervals: From 0 ft. to 20 ft., From ft. to ft., From ft. to ft.
 What is the nearest source of possible contamination:
 1 Septic tank 4 Lateral lines 7 Pit privy 10 Livestock pens 14 Abandoned water well
 2 Sewer lines 5 Cess pool 8 Sewage lagoon 11 Fuel storage 15 Oil well/Gas well
 3 Watertight sewer lines 6 Seepage pit 9 Feedyard 12 Fertilizer storage 16 Other (specify below)
 13 Insecticide storage
 Direction from well? None in View How many feet?

FROM	TO	LITHOLOGIC LOG	FROM	TO	PLUGGING INTERVALS
0	60	Clay			
60	80	gravel + clay			
80	100	gravel			
100	200	gravel + clay			
200	220	gravel, sand + clay			
220	240	gravel + sand			
240	260	green clay + sand			
260	280	gravel + sand			
280	300	gravel + some sand			
300	305	Shale			

7 CONTRACTOR'S OR LANDOWNER'S CERTIFICATION: This water well was (1) constructed, (2) reconstructed, or (3) plugged under my jurisdiction and was completed on (mo/day/year) 7-18-02 and this record is true to the best of my knowledge and belief. Kansas Water Well Contractor's Licence No. 484 This Water Well Record was completed on (mo/day/yr) 8-23-02 under the business name of Solaal Drilling Co. by (signature) Paul Schuch