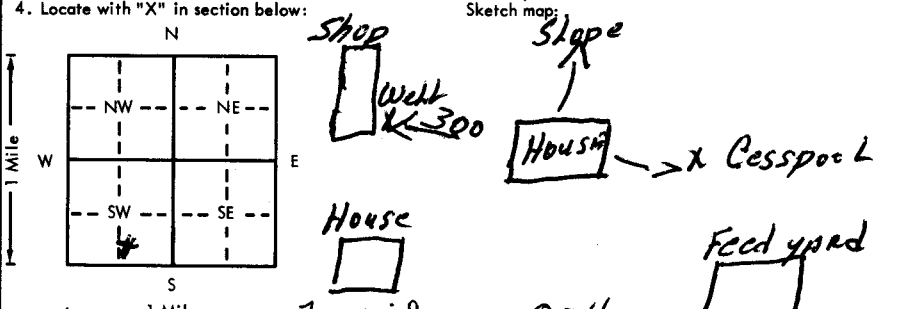


USE TYPEWRITER OR BALL POINT PEN-PRESS FIRMLY, PRINT CLEARLY.

WATER WELL RECORD
KSA 82a-1201-1215

Kansas Department of Health and Environment-Division of Environment (Water well Contractors) Topeka, Kansas 66620

CSC

1. Location of well: County: <u>SHERMAN</u>		Fraction: <u>SW 1/4 SE 1/4 SW 1/4</u>		Section number: <u>27</u>		Township number: T <u>7</u> S R <u>37</u> <u>4W</u>																																					
2. Distance and direction from nearest town or city: Street address of well location if in city: <u>Brewster</u> <u>4W 4 1/4 N</u>				3. Owner of well: <u>TROY DILLINGER</u> R.R. or street: City, state, zip code: <u>Brewster Kansas 67732</u>																																							
4. Locate with "X" in section below: 				6. Bore hole dia. <u>8</u> in. Completion date <u>1-16-76</u> Well depth <u>267</u> ft.																																							
5. Type and color of material				7. <input checked="" type="checkbox"/> Rotary <input type="checkbox"/> Driven <input type="checkbox"/> Dug <input type="checkbox"/> Hollow rod <input type="checkbox"/> Jetted <input type="checkbox"/> Bored <input type="checkbox"/> Reverse rotary																																							
<table border="1"> <thead> <tr> <th>From</th> <th>To</th> </tr> </thead> <tbody> <tr> <td>0-4</td> <td>4-79</td> </tr> <tr> <td>79-114</td> <td>114-143</td> </tr> </tbody> </table>				From	To	0-4	4-79	79-114	114-143	8. Use: <input checked="" type="checkbox"/> Domestic <input type="checkbox"/> Public supply <input type="checkbox"/> Industry <input type="checkbox"/> Irrigation <input type="checkbox"/> Air conditioning <input type="checkbox"/> Stock <input type="checkbox"/> Lawn <input type="checkbox"/> Oil field water <input type="checkbox"/> Other																																	
From	To	
0-4	4-79	
79-114	114-143	
<table border="1"> <tbody> <tr> <td>M GRAVEL, Sandy Clay</td> <td>143</td> <td>148</td> </tr> <tr> <td>M GRAVEL</td> <td>148</td> <td>157</td> </tr> <tr> <td>FINE SAND, Clay, SANDSTONE</td> <td>157</td> <td>187</td> </tr> <tr> <td>HARD SANDSTONE</td> <td>187</td> <td>191</td> </tr> <tr> <td>M GRAVEL, Sandy Clay</td> <td>191</td> <td>196</td> </tr> <tr> <td>M GRAVEL</td> <td>196</td> <td>202</td> </tr> <tr> <td>M GRAVEL, Sandy Clay, SANDSTONE</td> <td>202</td> <td>213</td> </tr> <tr> <td>M GRAVEL</td> <td>213</td> <td>216</td> </tr> <tr> <td>FINE SAND, Sandy Clay, SANDSTONE</td> <td>216</td> <td>240</td> </tr> <tr> <td>M GRAVEL</td> <td>240</td> <td>253</td> </tr> <tr> <td>M GRAVEL</td> <td>253</td> <td>267</td> </tr> <tr> <td>SANDY CLAY</td> <td>267</td> <td></td> </tr> </tbody> </table>				M GRAVEL, Sandy Clay	143	148	M GRAVEL	148	157	FINE SAND, Clay, SANDSTONE	157	187	HARD SANDSTONE	187	191	M GRAVEL, Sandy Clay	191	196	M GRAVEL	196	202	M GRAVEL, Sandy Clay, SANDSTONE	202	213	M GRAVEL	213	216	FINE SAND, Sandy Clay, SANDSTONE	216	240	M GRAVEL	240	253	M GRAVEL	253	267	SANDY CLAY	267		9. Casing: Material <u>Plastic</u> Height: Above or below Threaded <input type="checkbox"/> Welded <input type="checkbox"/> Surface <u>12</u> in. RMP <input type="checkbox"/> PVC <input checked="" type="checkbox"/> Weight <u>15</u> lbs./ft. Dia. <u>2 1/2</u> in. to <u>2 1/2</u> ft. depth Wall Thickness: inches or Dia. <u>2 1/2</u> in. to <u>2 1/2</u> ft. depth gage No. <u>200.237</u>			
Screen: Manufacturer's name <u>Jess + Lowell</u> Type <u>LAYER</u> Dia. <u>3</u> Slot/gauze <u>1/8, 200</u> Length <u>20</u> Set between <u>247</u> ft. and <u>267</u> ft. Gravel pack? <u>YES</u> Size range of material <u>1/8</u>			
18. Elevation:				11. Static water level: <u>149</u> ft. below land surface Date <u>1-16-76</u>																																							
19. Remarks:				12. Pumping level below land surfaces: <u>175</u> ft. after <u>3</u> hrs. pumping <u>15</u> g.p.m. Estimated maximum yield <u>50</u> g.p.m.																																							
Topography: <input type="checkbox"/> Hill <input type="checkbox"/> Slope <input checked="" type="checkbox"/> Upland <input type="checkbox"/> Valley				13. Water sample submitted: <u>NO</u> mo./day/yr.																																							
(Use a second sheet if needed)				14. Well head completion: <u>YES</u> Pitless adapter <u>12</u> inches above grade																																							
BROCK ?				15. Well grouted? <u>YES</u> With: <input checked="" type="checkbox"/> Neat cement <input type="checkbox"/> Bentonite <input checked="" type="checkbox"/> Concrete Depth: From <u>5</u> ft. to <u>15</u> ft.																																							
				16. Nearest source of possible contamination: ft. <u>300</u> Direction <u>NW</u> Type <u>Cesspool</u> Well disinfected upon completion? <input checked="" type="checkbox"/> Yes <input type="checkbox"/> No																																							
				17. Pump: <u>Not installed</u> Manufacturer's name <u>Red Jacket</u> Model number <u>11CS</u> HP <u>1/2</u> Volts <u>220</u> Length of drop pipe <u>220</u> ft. capacity <u>20</u> g.p.m. Type: <input checked="" type="checkbox"/> Submersible <input type="checkbox"/> Turbine <input type="checkbox"/> Jet <input type="checkbox"/> Reciprocating <input type="checkbox"/> Centrifugal <input type="checkbox"/> Other																																							
				20. Water well contractor's certification: This well was drilled under my jurisdiction and this report is true to the best of my knowledge and belief. <u>St H Dillinger Co Inc 166</u> License No. Business name <u>Hoodland Kansas</u> Address <u>Brewster Kansas</u> Signed <u>Bill Clifford</u> Date <u>2-11-76</u> Authorized representative																																							

T-7 37E 27 SW SE SW 1/4 1/4 1/4