


1 LOCATION OF WATER WELL: County: Sherman Section Number 34 Township Number T 7 S Range Number R 37 E/W

Distance and direction from nearest town or city street address of well if located within city?
 From Brewster, Kansas - $4\frac{1}{2}$ mi. west and $2\frac{1}{2}$ mi. North

2 WATER WELL OWNER: Troy Dillinger
 RR#, St. Address, Box #: Rt. 2 Board of Agriculture, Division of Water Resources
 City, State, ZIP Code: Brewster, Kansas 67732 Application Number: 35,907

3 LOCATE WELL'S LOCATION WITH AN IN SECTION BOX:

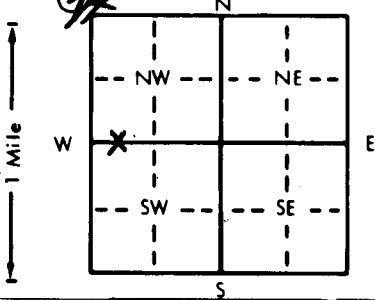

4 DEPTH OF COMPLETED WELL: 272 ft. ELEVATION: 3472
 Depth(s) Groundwater Encountered 1. 147 ft. 2. _____ ft. 3. _____ ft.
 WELL'S STATIC WATER LEVEL 147 ft. below land surface measured on mo/day/yr 5-7-82
 Pump test data: Well water was 192 ft. after 3 hours pumping 700 gpm
 Est. Yield 1100 gpm: Well water was 228 ft. after 3 1/2 hours pumping 1067 gpm
 Bore Hole Diameter 16 in. to 172 ft., and _____ in. to _____ ft.
 WELL WATER TO BE USED AS:
 5 Public water supply 8 Air conditioning 11 Injection well
 1 Domestic 3 Feedlot 6 Oil field water supply 9 Dewatering 12 Other (Specify below)
 2 Irrigation 4 Industrial 7 Lawn and garden only 10 Observation well
 Was a chemical/bacteriological sample submitted to Department? Yes _____ No X; If yes, mo/day/yr sample was submitted _____
 Water Well Disinfected? Yes _____ No X

5 TYPE OF BLANK CASING USED:
 1 Steel 3 RMP (SR) 5 Wrought iron 8 Concrete tile CASING JOINTS: Glued _____ Clamped _____
 2 PVC 4 ABS 6 Asbestos-Cement 9 Other (specify below) Welded _____
 7 Fiberglass _____ Threaded _____
 Blank casing diameter 16 in. to 182 ft., Dia _____ in. to _____ ft., Dia _____ in. to _____ ft.
 Casing height above land surface 12 in., weight _____ lbs./ft. Wall thickness or gauge No. 188
 TYPE OF SCREEN OR PERFORATION MATERIAL:
 1 Steel 3 Stainless steel 5 Fiberglass 7 PVC 10 Asbestos-cement
 2 Brass 4 Galvanized steel 6 Concrete tile 8 RMP (SR) 11 Other (specify) _____
 9 ABS 12 None used (open hole)
 SCREEN OR PERFORATION OPENINGS ARE:
 1 Continuous slot 3 Mill slot 5 Gauzed wrapped 8 Saw cut 11 None (open hole)
 2 Louvered shutter 4 Key punched 6 Wire wrapped 9 Drilled holes
 7 Torch cut 10 Other (specify) _____
 SCREEN-PERFORATED INTERVALS: From 182 ft. to 262 W.A. Brown ft., From _____ ft. to _____ ft.
 From 262 ft. to 272 Cook ft., From _____ ft. to _____ ft.
 GRAVEL PACK INTERVALS: From 10 ft. to 272 ft., From _____ ft. to _____ ft.
 From _____ ft. to _____ ft., From _____ ft. to _____ ft.

6 GROUT MATERIAL: 1 Neat cement 2 Cement grout 3 Bentonite 4 Other CEMENT
 Grout Intervals: From 0 ft. to 10 ft., From _____ ft. to _____ ft., From _____ ft. to _____ ft.
 What is the nearest source of possible contamination:
 1 Septic tank 4 Lateral lines 7 Pit privy 10 Livestock pens 14 Abandoned water well
 2 Sewer lines 5 Cess pool 8 Sewage lagoon 11 Fuel storage 15 Oil well/Gas well
 3 Watertight sewer lines 6 Seepage pit 9 Feedyard 12 Fertilizer storage 16 Other (specify below)
 13 Insecticide storage
 Direction from well? West North West How many feet? 1300

| FROM | TO | LITHOLOGIC LOG | FROM | TO | LITHOLOGIC LOG |
|------|-----|------------------------------------|------|-----|------------------------------------|
| 0 | 26 | Top soil, sand, sandy clay | 142 | 146 | Med. to coarse sand |
| 26 | 50 | Clay & Sandy caly | 146 | 164 | Sand, Coarse sand, sandstone, clay |
| 50 | 62 | Coarse sand to coarse gravel | 164 | 170 | Coarse sand to med. gravel |
| 62 | 72 | Med. to coarse sand | 170 | 185 | Sandstone and sandy caly |
| 72 | 74 | Sandstone | 185 | 196 | Sandstone & cemented Br. with clay |
| 74 | 79 | Coarse sand and gravel | 196 | 202 | Coarse sand to coarse gravel |
| 79 | 82 | Sandstone | 202 | 219 | Sandstone and clay |
| 82 | 90 | Coarse sand to coarse gravel | 219 | 223 | Coarse sand to coarse gr. w/clay |
| 90 | 102 | Coarse sand, sand stone, clay | 223 | 226 | Sandstone - HARD |
| 102 | 110 | Coarse sand to coarse gravel | 226 | 232 | Med. sand to med. gravel |
| 110 | 120 | Sandstone, coarse sand, coarse gr. | 232 | 237 | Sandstone and clay |
| 120 | 122 | Sandstone | 237 | 243 | Med sand to med. gravel |
| 122 | 126 | Med. to coarse sand | 243 | 264 | Med. sand to med. gr. |
| 126 | 138 | Sandstone & clay | 264 | 266 | Sandstone - hard |
| 138 | 142 | Clay | 266 | 270 | Coarse Gravel |
| | | | 270 | 272 | Ochre and Shale |

7 CONTRACTOR'S OR LANDOWNER'S CERTIFICATION: This water well was (1) constructed, (2) reconstructed, or (3) plugged under my jurisdiction and was completed on (mo/day/year) 5-7-82 and this record is true to the best of my knowledge and belief. Kansas Water Well Contractor's License No. 245 This Water Well Record was completed on (mo/day/yr) 5-29-82 under the business name of Western Well and Pump, Inc. by (signature) Roy F. Senior

INSTRUCTIONS: Use typewriter or ball point pen, PLEASE PRESS FIRMLY and PRINT clearly. Please fill in blanks, underline or circle the correct answers. Send top three copies to Kansas Department of Health and Environment, Division of Environment, Environmental Geology Section, Topeka, KS 66620. Send one to WATER WELL OWNER and retain one for your records.

OFFICE USE ONLY
T
R
37
SEC.
34
C
1/4
1/4
1/4