

USE TYPEWRITER OR BALL POINT PEN, PRESS FIRMLY, PRINT CLEARLY.

T R EW sec 1/4 1/4 1/4 No.


WATER WELL RECORD
KSA 82a-1201-1215

Kansas State Dept. Of Health
(Water Well Contractors)
Forbes-Bldg. 740
Topeka, Kansas 66620

AAA

1 Location of well: County Sherman Township name _____ Fraction NE-NE-NE Section number 35 Town number 7 S Range number 37 W

Distance and direction from nearest town or city: 3 W and 3 N of Brewster, Kansas 3 Owner of well: Mary & Ilene Deane
Street address of well location if in city: _____ Address: 3332 Yarrow St. Wheatridge, Colo. 80033

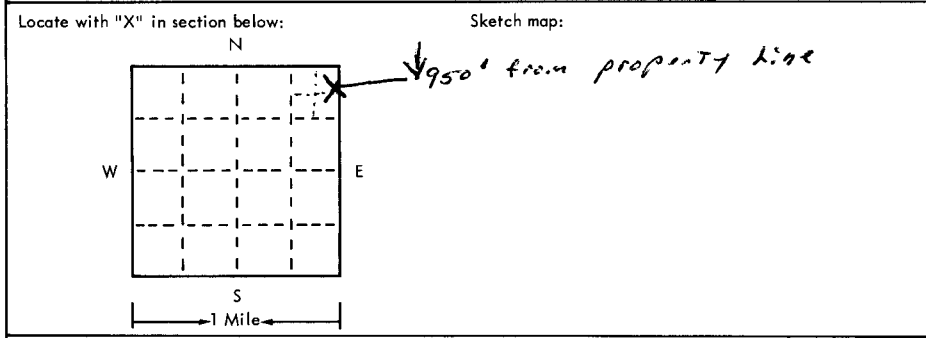

4 Well depth: 275 ft. Date of completion 2-13-76
Well diameter 28 in.

5 Cable tool Rotary Driven Dug
 Hollow rod Jetted Bored Reverse rotary

6 Use: Domestic Public supply Industry
 Irrigation Air conditioning Commercial
 Test well _____

7 Casing: Material Steel Height: above below
Threaded Welded Surface 12 in.
Diam. _____ Weight 40.5 lbs./ft. 1
16 in. to 185 ft. depth Drive shoe? Yes No
_____ in. to _____ ft. depth

2	Type and color of material	From	To
	Topsoil, Clay, Silty, Fine Sand, Brown	0	140
	Fine Sand, Med Gravel, Trace Sandstone	140	180
	Fine Sand, Med Gravel, Sandy clay, brown	180	190
	Fine Sand, Sandstone, brown, white	190	200
	Fine Sand, Med, Gravel, Trace Sandstone	200	210
	Fine Sand, Med Gravel, Traces Sandstone	210	217
	Sandstone, White	217	221
	Fine Sand, Med Gravel, Trace Sandstone	221	240
	Fine Sand, Trace Med Gravel, Trace Sandst	240	245
	Fine Sand, Med Gravel, Brown	245	250
	Fine Sand, Med Gravel, Traces Sandstone	250	270
	Ochre, yellow, Shale, Blue	270	275

8 Screen: Manufacturer W. A. Brown
Type Steel Dia. 16"
10 gauze 100 Free Flow Length 90'
Set between 195 ft. and 275 ft.
Fittings:
Gravel pack Yes No Size range of material 4-4

9 Static water level: 148 ft. below land surface Date 2-9-76

10 Pumping level below land surfaces:
260 ft. after 9 hrs. pumping 1185 g.p.m.
_____ ft. after _____ hrs. pumping _____ g.p.m.
Estimated maximum yield 1185 g.p.m.

11 Water sample submitted:
 Yes No Date _____

12 Well head completion:
 Pitless adapter None Inches above grade

13 Well grouted? Yes No
 Neat cement Bentonite _____
Depth: From 1 ft. to 10 ft.

14 Nearest source of possible contamination:
ft. 2 Mile Direction N Type Cess pool
Well disinfected upon completion? Yes No

15 Pump: Not installed
Manufacturer's name Gould
Model number _____ HP 110 Volts _____
Length of drop pipe 260 ft. capacity 1200 g.m.p.
Type:
 Submersible Turbine
 Jet Reciprocating
 Centrifugal Other

16 Remarks: elevation 3437 (TOD)

Topography:
 Hill
 Slope
 Upland
 Valley

17 Water well contractor's certification:
This well was drilled under my jurisdiction and this report is true to the best of my knowledge and belief.
Red Tiger Irrigation 125
Business name _____ License No. _____
Address Box 524 Colby, KS
Signed Ally P... 2-19-76 Date _____
Authorized representative

7 37 W 35 NENE NE