

USE TYPEWRITER OR BALL POINT PEN-PRESS FIRMLY, PRINT CLEARLY.

WATER WELL RECORD
KSA 82a-1201-1215


Kansas Department of Health and Environment-Division of Environment (Water well Contractors) Topeka, Kansas 66620

TWP: Shermanville

SAC

1. Location of well: County Sherman Fraction 1/4 ~~C~~ 1/4 SE 1/4 Section number 12 Township number T 7 S R 38 Range number X/W

2. Distance and direction from nearest town or city: 8 1/2 miles South; 1 mile East From Edson
Street address of well location if in city: None Location Location
3. Owner of well: Don McDaniels
R.R. or street:
City, state, zip code: Edson, Kansas

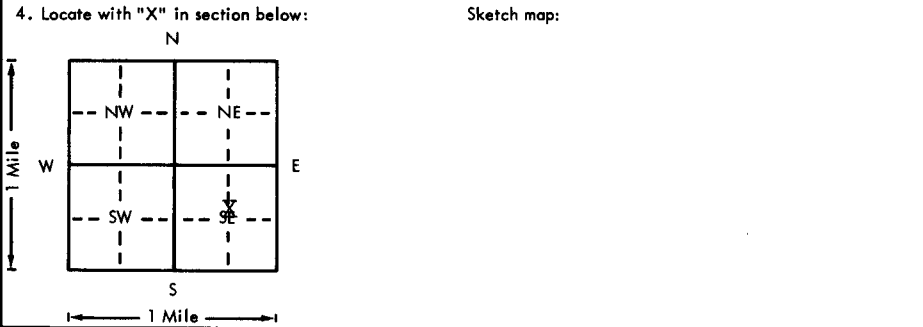

6. Bore hole dia. 30 in. Completion date 2/3/76
Well depth 315 ft.
7. Cable tool Rotary Driven Dug
 Hollow rod Jetted Bored Reverse rotary
8. Use: Domestic Public supply Industry
 Irrigation Air conditioning Stock
 Lawn Oil field water Other
9. Casing: Material Steel Height: Above or ~~X~~ X
Threaded Welded Surface 12 in.
RMP PVC Weight 7 gauge lbs./ft.
Dia. 16 in. to 205 ft. depth Wall thickness: inches or
Dia. 16 in. to 205 ft. depth gage No. .188

5. Type and color of material	From	To
Clay	0	76
Coarse sand & gravel	76	85
Clay & sand streaks	85	97
Coarse sand & gravel	97	120
Clay	120	127
Coarse sand & gravel	127	131
Clay	131	135
Sand	135	138
Clay	138	142
Coarse sand & gravel	142	154
Clay	154	163
Coarse sand & gravel	163	170
Clay	170	173
Coarse sand & gravel	173	179
Cemented sandstone	179	181
Clay & sand streaks	181	214
Sandstone	214	215
Sandy clay & sandstone streaks	215	233
Clay	233	237
Medium to coarse sand & clay streaks	237	246
Sandstone	246	251
Medium to coarse sand & cemented streaks	251	259
Medium to coarse sand	259	269
Clay	269	272
Medium to coarse sand & clay streaks	272	279
Coarse sand & clay streaks	279	288
Coarse sand	288	298
Clay	298	299
Very coarse sand	299	314
Ochre & shale	314	330

10. Screen: Manufacturer's name Brown
10' Cook
Type Regular Dia. 16"
Slot/gauze 107 Length 100' + 15'
Set between 205 ft. and 305 ft.
305 ft. and 315 ft.
Gravel pack? Size range of material X 5/8
11. Static water level: 141 ft. below land surface Date 2/8/76 mo./day/yr.
12. Pumping level below land surfaces:
210 ft. after 2 hrs. pumping 556 g.p.m.
300 ft. after 2 hrs. pumping 953 g.p.m.
Estimated maximum yield 953 g.p.m.
13. Water sample submitted: Y Yes N No Date
14. Well head completion:
 Pitless adapter 12 Inches above grade
15. Well grouted? Yes
With: Neat cement Bentonite Clay Concrete
Depth: From 0 ft. to 10 ft.
16. Nearest source of possible contamination:
ft. 5000 Direction All Type Farm
Well disinfected upon completion? Yes No
17. Pump: Not installed
Manufacturer's name Floway
Model number 7626 HP 100 Volts
Length of drop pipe 313 ft. capacity 550 g.p.m.
Type:
 Submersible Turbine
 Jet Reciprocating
 Centrifugal Other

18. Elevation:
19. Remarks: BROOK 314
Topography:
 Hill
 Slope
 Upland
 Valley

20. Water well contractor's certification:
This well was drilled under my jurisdiction and this report is true to the best of my knowledge and belief.
Western Well & Pump 245
Business name License No.
Address PO Box 852 Colby, Ks.
Signature Sally Berry Date 4-12-76
Authorized representative

N
R
W
E
S
1/2
1/4
1/4
1/4