


USE TYPEWRITER OR BALL POINT PEN-PRESS FIRMLY, PRINT CLEARLY.

WATER WELL RECORD
KSA 82a-1201-1215

Kansas Department of Health and Environment-Division of Environment
(Water well Contractors)
Topeka, Kansas 66620

BBB

1. Location of well:		County SHERMAN	Fraction NW 1/4 NW 1/4 NW 1/4	Section number 26	Township number T 7 S R 38 E 10	Range number
2. Distance and direction from nearest town or city: 8 1/2 MI E OF EDISON			3. Owner of well: EDWIN DEEDS			
Street address of well location if in city:			R.R. or street:			
			City, state, zip code: GOODLAND, KANS 67735			
4. Locate with "X" in section below:		Sketch map:		6. Bore hole dia. 16 in. Completion date 2-2-76 Well depth 325 ft.		
				7. <input type="checkbox"/> Cable tool <input type="checkbox"/> Rotary <input type="checkbox"/> Driven <input type="checkbox"/> Dug <input type="checkbox"/> Hollow rod <input type="checkbox"/> Jetted <input type="checkbox"/> Bored <input checked="" type="checkbox"/> Reverse rotary		
5. Type and color of material				8. Use: <input checked="" type="checkbox"/> Domestic <input type="checkbox"/> Public supply <input type="checkbox"/> Industry <input checked="" type="checkbox"/> Irrigation <input type="checkbox"/> Air conditioning <input type="checkbox"/> Stock <input type="checkbox"/> Lawn <input type="checkbox"/> Oil field water <input type="checkbox"/> Other		
				9. Casing: Material Steel Height: Above or below Threaded <input type="checkbox"/> Welded <input checked="" type="checkbox"/> Surface 8 in. RMP <input type="checkbox"/> PVC <input type="checkbox"/> Weight 37 lbs./ft. Dia. 16 in. to 325 ft. depth Wall Thickness: inches or Dia. <input type="checkbox"/> in. to <input type="checkbox"/> ft. depth gage No. 188		
				10. Screen: Manufacturer's name K.A. BROWN Type WELL SOFT Dia. 16" Slot/gauze 1/8 Length 20' Set between 200 ft. and 325 ft. ft. and <input type="checkbox"/> ft. Gravel pack? <input checked="" type="checkbox"/> Size range of material 1/2"		
				11. Static water level: <input type="checkbox"/> mo./day/yr. 141 ft. below land surface Date 3-25-76		
				12. Pumping level below land surfaces: 150 ft. after 8 hrs. pumping 800 g.p.m. 220 ft. after 16 hrs. pumping 1140 g.p.m. Estimated maximum yield 1140 g.p.m.		
				13. Water sample submitted: <input type="checkbox"/> mo./day/yr. <input type="checkbox"/> Yes <input checked="" type="checkbox"/> No Date <input type="checkbox"/>		
				14. Well head completion: <input type="checkbox"/> Pitless adapter <input type="checkbox"/> Inches above grade		
				15. Well grouted? <input checked="" type="checkbox"/> With: <input type="checkbox"/> Neat cement <input type="checkbox"/> Bentonite <input checked="" type="checkbox"/> Concrete Depth: From 10 ft. to 8" Above		
				16. Nearest source of possible contamination: ft. <input type="checkbox"/> Direction <input type="checkbox"/> Type <input type="checkbox"/> Well disinfected upon completion? <input type="checkbox"/> Yes <input type="checkbox"/> No		
				17. Pump: <input type="checkbox"/> Not installed Manufacturer's name TAIT A/C Model number 124CCM HP <input type="checkbox"/> Volts <input type="checkbox"/> Length of drop pipe <input type="checkbox"/> ft. capacity <input type="checkbox"/> g.p.m. Type: <input type="checkbox"/> Submersible <input checked="" type="checkbox"/> Turbine <input type="checkbox"/> Jet <input type="checkbox"/> Reciprocating <input type="checkbox"/> Centrifugal <input type="checkbox"/> Other		
				20. Water well contractor's certification: This well was drilled under my jurisdiction and this report is true to the best of my knowledge and belief. Toussaint Supply Co Inc 144 Business name License No. Address Box 338 Goodland Signed Ralph Eifman Date 4-1-76 Authorized representative		
18. Elevation:		19. Remarks: 3533 (TOP)				
Topography: <input type="checkbox"/> Hill <input checked="" type="checkbox"/> Slope <input type="checkbox"/> Upland <input type="checkbox"/> Valley						

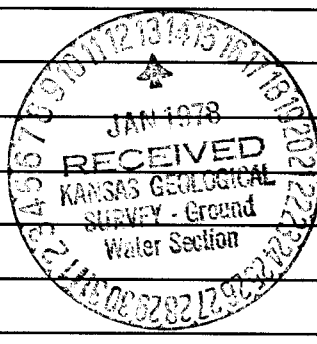

17 3 80 26 NW NW NW
 R
 Sec
 1/4 1/4 1/4