


1 LOCATION OF WATER WELL: Fraction SW 1/4 SW 1/4 SE 1/4 Section Number 31 Township Number T 7 S Range Number R 38 E/W
 County: Sherman
 Distance and direction from nearest town or city street address of well if located within city?

2 WATER WELL OWNER:
 RR#, St. Address, Box # : 67735 Board of Agriculture, Division of Water Resources

3 LOCATE WELL'S LOCATION WITH AN "X" IN SECTION BOX:

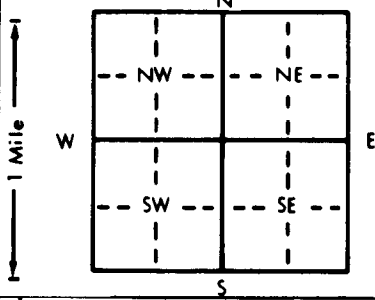

4 DEPTH OF COMPLETED WELL..... ft. ELEVATION: ft.
 Depth(s) Groundwater Encountered 1..... ft. 2..... ft. 3..... ft.
 WELL'S STATIC WATER LEVEL..... ft. below land surface measured on mo/day/yr
 Pump test data: Well water was ft. after hours pumping gpm
 Est. Yield gpm: Well water was ft. after hours pumping gpm
 Bore Hole Diameter..... in. to ft., and..... in. to ft.
 WELL WATER TO BE USED AS:
 Domestic 3 Feedlot 6 Oil field water supply 9 Dewatering 12 Other (Specify below)
 2 Irrigation 4 Industrial 7 Lawn and garden only 10 Monitoring well
 Was a chemical/bacteriological sample submitted to Department? Yes.....No.....; If yes, mo/day/yr sample was submitted
 Water Well Disinfected? Yes No

5 TYPE OF BLANK CASING USED:
 1 Steel 3 RMP (SR) 5 Wrought iron 8 Concrete tile CASING JOINTS: Glued.....Clamped.....
 2 PVC 4 ABS 6 Asbestos-Cement 9 Other (specify below) Welded.....
 7 Fiberglass Threaded.....
 Blank casing diameter..... in. to ft., Dia..... in. to ft., Dia..... in. to ft.
 Casing height above land surface..... in., weight..... lbs./ft. Wall thickness or gauge No.
 TYPE OF SCREEN OR PERFORATION MATERIAL:
 1 Steel 3 Stainless steel 5 Fiberglass 7 PVC 10 Asbestos-cement
 2 Brass 4 Galvanized steel 6 Concrete tile 8 RMP (SR) 11 Other (specify)
 9 ABS 12 None used (open hole)
 SCREEN OR PERFORATION OPENINGS ARE:
 1 Continuous slot 3 Mill slot 5 Gauzed wrapped 8 Saw cut 11 None (open hole)
 2 Louvered shutter 4 Key punched 6 Wire wrapped 9 Drilled holes
 7 Torch cut 10 Other (specify)
 SCREEN-PERFORATED INTERVALS: From..... ft. to ft., From..... ft. to ft.
 From..... ft. to ft., From..... ft. to ft.
 GRAVEL PACK INTERVALS: From..... ft. to ft., From..... ft. to ft.
 From..... ft. to ft., From..... ft. to ft.

6 GROUT MATERIAL: 1 Neat cement 2 Cement grout 3 Bentonite 4 Other
 Grout intervals: From..... ft. to ft., From..... ft. to ft., From..... ft. to ft.
 What is the nearest source of possible contamination:
 1 Septic tank 4 Lateral lines 7 Pit privy 10 Livestock pens 14 Abandoned water well
 2 Sewer lines 5 Cess pool 8 Sewage lagoon 11 Fuel storage 15 Oil well/Gas well
 3 Watertight sewer lines 6 Seepage pit 9 Feedyard 12 Fertilizer storage 16 Other (specify below)
 13 Insecticide storage
 Direction from well? How many feet?

FROM	TO	LITHOLOGIC LOG	FROM	TO	PLUGGING INTERVALS
			bottom	5' level	Clear/Sand
			5'	3'	Bentonite
			3'	Top of Ground	fill dirt

RECEIVED
 APR 30 1990
 DIVISION OF ENVIRONMENT

7 CONTRACTOR'S OR LANDOWNER'S CERTIFICATION: This water well was (1) constructed, (2) reconstructed, or (3) plugged under my jurisdiction and was completed on (mo/day/year) 1-9-90 and this record is true to the best of my knowledge and belief. Kansas Water Well Contractor's License No. This Water Well Record was completed on (mo/day/yr) under the business name of B's Pump & Well by (signature) Rex Smith

OFFICE USE ONLY
 T
 R
 EW
 SEC.
 1/4
 1/4
 1/4