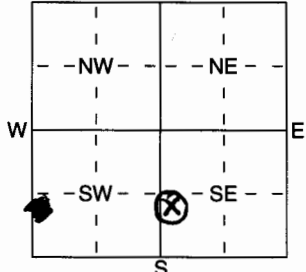


1 LOCATION OF WATER WELL: Fraction NW 1/4 SW 1/4 SE 1/4 Section Number 12 Township Number T 7 S Range Number R 39 EW
 County: SHERMAN

Distance and direction from nearest town or city street address of well if located within city?
HE-8N OF GOODLAND

2 WATER WELL OWNER: PETE FITZGIBBONS
 RR#, St. Address, Box # : 6930 HWY 27
 City, State, ZIP Code : GOODLAND, KS 67735
 Board of Agriculture, Division of Water Resources
 Application Number:

3 LOCATE WELL'S LOCATION WITH AN "X" IN SECTION BOX:

 4 DEPTH OF COMPLETED WELL 240 ft. ELEVATION:
 Depth(s) Groundwater Encountered 1 130 ft. 2 130 ft. 3 130 ft.
 WELL'S STATIC WATER LEVEL 130 ft. below land surface measured on mo/day/yr 5-31-06
 Pump test data: Well water was ft. after hours pumping gpm
 Est. Yield 20 gpm: Well water was ft. after hours pumping gpm
 WELL WATER TO BE USED AS:
 1 Domestic 3 Feedlot 6 Oil field water supply 9 Dewatering 12 Other (Specify below)
 2 Irrigation 4 Industrial 7 Domestic (lawn & garden) 10 Monitoring well
 Was a chemical/bacteriological sample submitted to Department? Yes No X; If yes, mo/day/yr sample was submitted
 Water Well Disinfected? Yes No

5 TYPE OF BLANK CASING USED:
 1 PVC 3 RMP (SR) 5 Wrought iron 8 Concrete tile CASING JOINTS: Glued Clamped
 2 PVC 4 ABS 6 Asbestos-Cement 9 Other (specify below) Welded
 7 Fiberglass Threaded
 Blank casing diameter 5 in. to 220 ft. Dia in. to ft. Dia in. to ft.
 Casing height above land surface 12 in., weight 200 lbs./ft. Wall thickness or gauge No. SR 20
 TYPE OF SCREEN OR PERFORATION MATERIAL:
 1 Steel 3 Stainless Steel 5 Fiberglass 8 PVC 10 Asbestos-Cement
 2 Brass 4 Galvanized Steel 6 Concrete tile 9 ABS 11 Other (Specify)
 12 None used (open hole)
 SCREEN OR PERFORATION OPENINGS ARE:
 1 Continuous slot 3 Mill slot 5 Gauzed wrapped 8 Saw cut 11 None (open hole)
 2 Louvered shutter 4 Key punched 6 Wire wrapped 9 Drilled holes
 7 Torch cut 10 Other (specify) ft.
 SCREEN-PERFORATED INTERVALS: From 220 ft. to 240 ft., From ft. to ft.
 From ft. to ft., From ft. to ft.
 GRAVEL PACK INTERVALS: From ft. to ft., From ft. to ft.
PEA GRAVEL From 20 ft. to 240 ft., From ft. to ft.

6 GROUT MATERIAL: Neat cement 2 Cement grout 3 Bentonite 4 Other
 Grout Intervals: From 0 ft. to 20 ft., From ft. to ft., From ft. to ft.
 What is the nearest source of possible contamination:
 1 Septic tank 4 Lateral lines 7 Pit privy 10 Livestock pens 14 Abandoned water well
 2 Sewer lines 5 Cess pool 8 Sewage lagoon 11 Fuel storage 15 Oil well/Gas well
 3 Watertight sewer lines 6 Seepage pit 9 Feedyard 12 Fertilizer storage 16 Other (specify below)
 13 Insecticide storage
 Direction from well? NONE IN VIEW How many feet?

FROM	TO	LITHOLOGIC LOG	FROM	TO	PLUGGING INTERVALS
<u>0</u>	<u>20</u>	<u>SAND - TOP SOIL</u>			
<u>20</u>	<u>40</u>	<u>SAND - CLAY - GRAVEL</u>			
<u>40</u>	<u>80</u>	<u>GRAVEL</u>			
<u>80</u>	<u>120</u>	<u>GRAVEL - CLAY</u>			
<u>120</u>	<u>140</u>	<u>GRAVEL - SAND</u>			
<u>140</u>	<u>220</u>	<u>SAND</u>			
<u>220</u>	<u>240</u>	<u>GRAVEL - CLAY - SHALE</u>			

7 CONTRACTOR'S OR LANDOWNER'S CERTIFICATION: This water well was (1) constructed, (2) reconstructed, or (3) plugged under my jurisdiction and was completed on (mo/day/year) 5-31-06 and this record is true to the best of my knowledge and belief. Kansas Water Well Contractor's Licence No 484. This Water Well Record was completed on (mo/day/yr) 6-18-06 under the business name of SCHAAL DRILLING Co. by (signature) [Signature]