USE TYPEWRITER OR BALL POINT PEN-PRESS FIRMLY, PRINT CLEARLY.

WATER WELL RECORD
KSA 82a-1201-1215

~~HIC~~ DBA

Kansas Department of Health and Environment-Division of Environment
(Water well Contractors)
Topeka, Kansas 66620

1. Location of well:	County	Fraction	Section number	Township number	Range number
	Sherman	~~SW~~ E 1/4 SE 1/4 NE 1/4	29	T 7 S	R 39 (W)

2. Distance and direction from nearest town or city: Goodland
Street address of well location if in city: 4N 1E ½N ¼W

3. Owner of well: Richard Whitmore
R.R. or street: 716 College
City, state, zip code: Goodland Kansas 67735

4. Locate with "X" in section below:

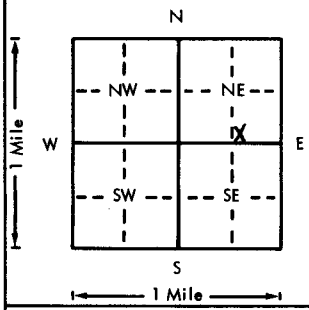

Sketch map:

6. Bore hole dia. 26 in. Completion date 7-6-76
Well depth 320 ft.

7. __ Cable tool __ Rotary __ Driven __ Dug
__ Hollow rod __ Jetted __ Bored X Reverse rotary

8. Use: __ Domestic __ Public supply __ Industry
X Irrigation __ Air conditioning __ Stock
__ Lawn __ Oil field water __ Other

9. Casing: Material Steel Height: Above ~~or below~~
Threaded ___ Welded X Surface 12 in.
RMP ___ PVC ___ Weight 36 lbs./ft.
Dia. 16 in. to 190 ft. depth Wall Thickness: inches or
Dia. ___ in. to ___ ft. depth gage No. .219

5. Type and color of material	From	To
Sandy Clay, Sandstone	131	144
M Gravel	144	151
M Gravel, Sandstone	151	173
Fine Sand, Sandy Clay	173	194
M Gravel	194	205
Sandy Clay	205	222
Fine Sand, Sandy Clay	222	269
Fine Sand, Streaks Clay	269	311
Fine Sand, M Gravel	311	317
Ochre	317	320
(Use a second sheet if needed)		

10. Screen: Manufacturer's name W. A. Brown
Type Louver Dia. 16
Slot/gauze 18 x 7 Length 130
Set between 190 ft. and 320 ft.
___ ft. and ___ ft.
Gravel pack? yes Size range of material 14 x 38

11. Static water level: mo./day/yr.
138 ft. below land surface Date 5-24-76

12. Pumping level below land surfaces:
243 ft. after 5 hrs. pumping 700 g.p.m.
300 ft. after 5 hrs. pumping 850 g.p.m.
Estimated maximum yield 900 g.p.m.

13. Water sample submitted: mo./day/yr.
__ Yes X No Date ___

14. Well head completion:
__ Pitless adapter ___ Inches above grade

15. Well grouted? yes
With: __ Neat cement __ Bentonite X Concrete
Depth: From 0 ft. to 10 ft.

16. Nearest source of possible contamination:
ft. ___ Direction ___ Type None
Well disinfected upon completion? ___ Yes X No

17. Pump: __ Not installed
Manufacturer's name Western Land Roller
Model number 6M HP 100 Volts ___
Length of drop pipe 300 ft. capacity 900 g.p.m.
Type:
__ Submersible X Turbine
__ Jet __ Reciprocating
__ Centrifugal __ Other

18. Elevation:
Topography:
__ Hill
__ Slope
X Upland
__ Valley

19. Remarks: 3630 (TOPO)

20. Water well contractor's certification:
This well was drilled under my jurisdiction and this report is true to the best of my knowledge and belief.
S & H Drilling Co Inc 166
Business name License No.
Address Goodland Kansas
Signed Bill Clifford Date
Authorized representative 7-13-76

T 7 R 39 E Sec 29 1/4 SW 1/4 SE 1/4 NE 1/4

Forward the white, blue and pink copies to the Department of Health and Environment

Form WWC-5