

USE TYPEWRITER OR BALL POINT PEN—PRESS FIRMLY, PRINT CLEARLY.


WATER WELL RECORD
KSA 82a-1201-1215

Kansas Department of Health and Environment—Division of Environment
(Water well Contractors)
Topeka, Kansas 66620

BCC

1. Location of well: County Sherman Fraction SW 1/4 SW 1/4 NW 1/4 Section number 29 Township number T 7 S Range number R 39 (NW)

2. Distance and direction from nearest town or city: 5 North of 3. Owner of well: Pon Jamison & Jamison
Street address of well location if in city: Goodland Kans. R.R. or street:
City, state, zip code: Goodland Kans.

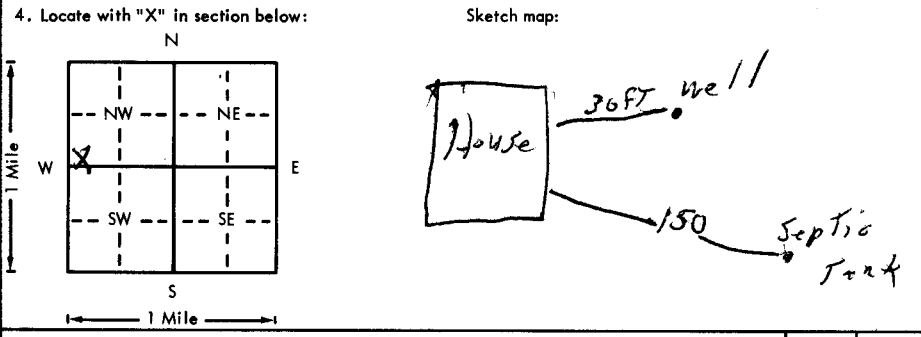

6. Bore hole dia. 3 in. Completion date 10-3-76
Well depth: 243 ft.

7. Cable tool Rotary Driven Dug
 Hollow rod Jetted Bored Reverse rotary

8. Use: Domestic Public supply Industry
 Irrigation Air conditioning Stock
 Lawn Oil field water Other

9. Casing: Material PFS Height: Above or below
Threaded Welded W Surface TS in.
RMP PVC Weight lbs./ft.
Dia. 5 in. to 243 ft. depth Wall Thickness: inches or
Dia. in. to ft. depth Gauge No. 250

5. Type and color of material	From	To
<u>Top Soil</u>	<u>0</u>	<u>2</u>
<u>yellow Clay</u>	<u>2</u>	<u>60</u>
<u>5' H - Clay layer SR</u>	<u>60</u>	<u>100</u>
<u>Rock</u>	<u>100</u>	<u>101</u>
<u>5' H - Clay layer SR</u>	<u>101</u>	<u>160</u>
<u>Rock</u>	<u>160</u>	<u>161</u>
<u>Sand & gravel - Clay</u>	<u>161</u>	<u>209</u>
<u>Sand & gravel - Clay SR</u>	<u>209</u>	<u>216</u>
<u>Rock</u>	<u>216</u>	<u>217</u>
<u>Sand & gravel - Clay</u>	<u>217</u>	<u>243</u>
<u>Did n't go to Shale</u>		

10. Screen: Manufacturer's name JAL
Type Dia. 5
Slot gauge Length 10' mnc
Set between 233 ft. and 243 ft.
 ft. and ft.
Gravel pack? Size range of material 18

11. Static water level: 94 ft. below land surface Date 10-3-76 mo./day/yr.

12. Pumping level below land surfaces:
 ft. after hrs. pumping g.p.m.
 ft. after hrs. pumping g.p.m.
Estimated maximum yield 10 g.p.m.

13. Water sample submitted: mo./day/yr.
Yes No Date

14. Well head completion: Pitless adapter 18 Inches above grade

15. Well grouted? yes
With: Negt cement Bentonite Concrete
Depth: From 4 ft. to 14 ft.

16. Nearest source of possible contamination:
ft. 26 Direction SE Type Septic tank
Well disinfected upon completion? Yes No


17. Pump: Not installed
Manufacturer's name Red Jacket
Model number 1150 HP 1 1/2 Volts
Length of drop pipe 768 ft. capacity 10 g.p.m.
Type:
 Submersible Turbine
 Jet Reciprocating
 Centrifugal Other

18. Elevation: 3580 (Topo)

19. Remarks:

Topography:
 Hill
 Slope
 Upland
 Valley

20. Water well contractor's certification:
This well was drilled under my jurisdiction and this report is true to the best of my knowledge and belief.
Schneberger License No. 1848
Business name License No.
Address St. James, KS
Signed Date 4/20/77
Authorized representative

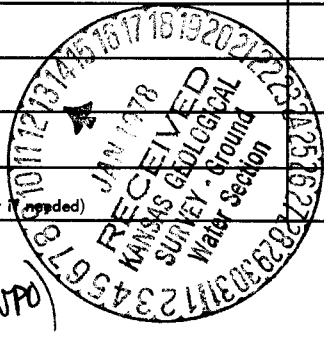

T 7 S R 39 E 29 Sec 29 SW SW NW 1/4 1/4 SW NW