

USE TYPEWRITER OR BALL POINT PEN-PRESS FIRMLY, PRINT CLEARLY.


WATER WELL RECORD
KSA 82a-1201-1215

Kansas Department of Health and Environment-Division of Environment
(Water well Contractors)
Topeka, Kansas 66620

BCC

1. Location of well: County SHERMAN Fraction SW 1/4 SW 1/4 NW 1/4 Section number 29 Township number T 7 Range number S R 39 AW

2. Distance and direction from nearest town or city: Goodland
Street address of well location if in city: 5 N
3. Owner of well: Lyle Smith
R.R. or street: Box 626
City, state, zip code: Goodland Kansas 67735

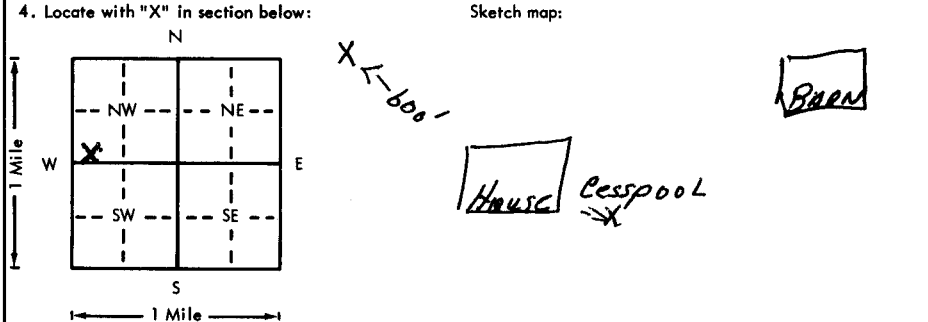

6. Bore hole dia. 9 in. Completion date 9-1-76
Well depth 221 ft.
7. Cable tool Rotary Driven Dug
 Hollow rod Jetted Bored Reverse rotary
8. Use: Domestic Public supply Industry
 Irrigation Air conditioning Stock
 Lawn Oil field water Other
9. Casing: Material Plastic Height: Above or below
Threaded Welded Surface 12 in.
RMP PVC Weight 28 lbs./ft.
Dia. 5 in. to 193 ft. depth Wall Thickness: inches or
Dia. in. to ft. depth gage No. 200

5. Type and color of material	From	To
<u>M GRAVEL, SANDY CLAY</u>	<u>70</u>	<u>92</u>
<u>FINE SAND, SANDY CLAY</u>	<u>92</u>	<u>98</u>
<u>M GRAVEL</u>	<u>98</u>	<u>103</u>
<u>CLAY, M GRAVEL</u>	<u>103</u>	<u>113</u>
<u>FINE SAND M GRAVEL</u>	<u>113</u>	<u>119</u>
<u>FINE SAND,</u>	<u>119</u>	<u>129</u>
<u>M GRAVEL, SANDY CLAY</u>	<u>129</u>	<u>199</u>
<u>M GRAVEL</u>	<u>199</u>	<u>215</u>
<u>M GRAVEL, CLAY</u>	<u>215</u>	<u>221</u>
<u> ? </u>	<u> </u>	<u> </u>
<u> </u>	<u> </u>	<u> </u>
<u> </u>	<u> </u>	<u> </u>
<u> </u>	<u> </u>	<u> </u>
<u> </u>	<u> </u>	<u> </u>

10. Screen: Manufacturer's name Jess + Lowell
Type Louyer Dia. 5
Slot/gauze 1/8 200 Length 28
Set between 193 ft. and 221 ft.
 ft. and ft.
Gravel pack? Yes Size range of material 1/8
11. Static water level: 70 ft. below land surface Date 8-16-76 mo./day/yr.
12. Pumping level below land surfaces:
95 ft. after 3 hrs. pumping 20 g.p.m.
 ft. after hrs. pumping g.p.m.
Estimated maximum yield 50 g.p.m.
13. Water sample submitted: mo./day/yr.
 Yes No Date
14. Well head completion:
 Pitless adapter Inches above grade
15. Well grouted? Yes
With: Neat cement Bentonite Concrete
Depth: From 0 ft. to 10 ft.
16. Nearest source of possible contamination: Cess
ft. 600' Direction SE Type Pool
Well disinfected upon completion? Yes No
17. Pump: Not installed
Manufacturer's name Red Jacket
Model number 13FC HP 3 Volts 230
Length of drop pipe 168 ft. capacity 50 g.p.m.
Type:
 Submersible Turbine
 Jet Reciprocating
 Centrifugal Other

18. Elevation: 3575 (TOP)
19. Remarks:
20. Water well contractor's certification:
This well was drilled under my jurisdiction and this report is true to the best of my knowledge and belief.
Business name S+H Drilling Co Inc License No. 166
Address Goodland Kan
Signed Bill Clifford Date 9-1-76
Authorized representative

T 7 3 9 2 9 SW SW NW Sec 1/4 1/4 1/4