


USE TYPEWRITER OR BALL POINT PEN—PRESS FIRMLY, PRINT CLEARLY.

WATER WELL RECORD  
KSA 82a-1201-1215

Kansas Department of Health and Environment—Division of Environment  
(Water well Contractors)  
Topeka, Kansas 66620

~~BBC~~ **BBC**

1. Location of well:		County <b>SHERMAN</b>	Fraction <b>NW 1/4 NW 1/4 NW 1/4</b>	Section number <b>35</b>	Township number <b>T 7</b>	Range number <b>S R 39 E 0</b>
2. Distance and direction from nearest town or city: <b>3 1/2 SE 3/4 N of GOODLAND</b>			3. Owner of well: <b>WALKER BRINEX</b> R.R. or street: <b>RT1</b> City, state, zip code: <b>GOODLAND, KANSAS</b>			
4. Locate with "X" in section below:		Sketch map:			6. Bore hole dia. <b>3 1/2</b> in. Completion date <b>12-6-75</b> Well depth <b>321</b> ft.	
					7. <input type="checkbox"/> Cable tool <input type="checkbox"/> Rotary <input type="checkbox"/> Driven <input type="checkbox"/> Dug <input type="checkbox"/> Hollow rod <input type="checkbox"/> Jetted <input type="checkbox"/> Bored <input checked="" type="checkbox"/> Reverse rotary	
5. Type and color of material		From	To	8. Use: <input type="checkbox"/> Domestic <input type="checkbox"/> Public supply <input type="checkbox"/> Industry <input checked="" type="checkbox"/> Irrigation <input type="checkbox"/> Air conditioning <input type="checkbox"/> Stock <input type="checkbox"/> Lawn <input type="checkbox"/> Oil field water <input type="checkbox"/> Other		
<b>Top Soil</b>		<b>0</b>	<b>3</b>	9. Casing: Material <b>Steel</b> Height: <b>Above or below</b> Threaded <input type="checkbox"/> Welded <input checked="" type="checkbox"/> Surface <b>8 1/2</b> in. RMP <input type="checkbox"/> PVC <input checked="" type="checkbox"/> Weight <b>37</b> lbs./ft. Dia. <b>1 1/2</b> in. to <b>321</b> ft. depth Wall Thickness: inches or Dia. <input type="checkbox"/> in. to <input type="checkbox"/> ft. depth Gage No. <b>188</b>		
<b>Clay Sandstone &amp; Gravel</b>		<b>3</b>	<b>164</b>	10. Screen: Manufacturer's name <b>W. A. Brown</b> Type <b>Mill slot</b> Dia. <b>1 1/2</b> " Slot/gauze <b>1/8</b> Length <b>20</b> " Set between <b>181</b> ft. and <b>321</b> ft. ft. and <input type="checkbox"/> ft. Gravel pack? <input checked="" type="checkbox"/> Size range of material <b>1/2 X 3/8</b>		
<b>Gravel</b>		<b>164</b>	<b>171</b>	11. Static water level: <input type="checkbox"/> mo./day/yr. <b>164</b> ft. below land surface Date <b>12-6-75</b>		
<b>Clay &amp; Sandstone</b>		<b>171</b>	<b>196</b>	12. Pumping level below land surfaces: <b>180</b> ft. after <b>8</b> hrs. pumping <b>930</b> g.p.m. <b>250</b> ft. after <b>16</b> hrs. pumping <b>1040</b> g.p.m. Estimated maximum yield <b>1040</b> g.p.m.		
<b>Sand</b>		<b>196</b>	<b>201</b>	13. Water sample submitted: <input type="checkbox"/> mo./day/yr. Yes <input checked="" type="checkbox"/> No <input type="checkbox"/> Date <input type="checkbox"/>		
<b>Sandstone &amp; Clay</b>		<b>201</b>	<b>235</b>	14. Well head completion: <input type="checkbox"/> Pitless adapter <input type="checkbox"/> Inches above grade		
<b>Sand</b>		<b>235</b>	<b>237</b>	15. Well grouted? <input checked="" type="checkbox"/> With: <input type="checkbox"/> Neat cement <input type="checkbox"/> Bentonite <input checked="" type="checkbox"/> Concrete Depth: From <b>10</b> ft. to <b>8"</b> above		
<b>Sandstone &amp; Clay</b>		<b>237</b>	<b>262</b>	16. Nearest source of possible contamination: ft. <input type="checkbox"/> Direction <input type="checkbox"/> Type <input type="checkbox"/> Well disinfected upon completion? <input type="checkbox"/> Yes <input type="checkbox"/> No		
<b>Fine Sand</b>		<b>262</b>	<b>264</b>	17. Pump: <input type="checkbox"/> Not installed Manufacturer's name <b>AFC TAIT</b> Model number <b>15122H</b> HP <b>150</b> Volts <b>460</b> Length of drop pipe <b>310</b> ft. capacity <b>1040</b> g.p.m. Type: <input type="checkbox"/> Submersible <input checked="" type="checkbox"/> Turbine <input type="checkbox"/> Jet <input type="checkbox"/> Reciprocating <input type="checkbox"/> Centrifugal <input type="checkbox"/> Other		
<b>Sandstone</b>		<b>264</b>	<b>298</b>	20. Water well contractor's certification: This well was drilled under my jurisdiction and this report is true to the best of my knowledge and belief. <b>Forest Supply Co. Inc. 144</b> Business name <b>Boyl 388 Goodland KS 66606</b> License No. <b>15446</b> Address <b>Boyl 388 Goodland KS 66606</b> Signed <b>Ralph Elmer mg</b> Date <b>3-31-76</b> Authorized representative		
<b>Clay</b>		<b>298</b>	<b>311</b>			
<b>Gravel</b>		<b>311</b>	<b>319</b>			
<b>Soapstone</b>		<b>319</b>	<b>321</b>			
<b>Shale</b>		<b>321</b>	<b>328</b>			
18. Elevation:		19. Remarks:				
Topography: <input type="checkbox"/> Hill <input checked="" type="checkbox"/> Slope <input type="checkbox"/> Upland <input type="checkbox"/> Valley		<b>3550</b> (TOPO) <b>Concrete slab was Run by Forest Supply.</b>				

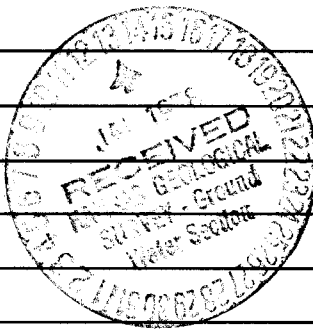

T 7 R 39 E 35 NW 1/4