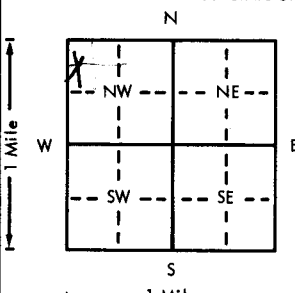
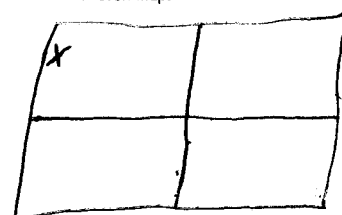


USE TYPEWRITER OR BALL
POINT PEN-PRESS FIRMLY,
PRINT CLEARLY.

WATER WELL RECORD
KSA 82a-1201-1215

Kansas Department of Health and
Environment-Division of Environment
(Water well Contractors)
Topeka, Kansas 66620

1. Location of well:		County SHERMAN	Fraction SW 1/4 NW 1/4 S 29 E 7	Section number 35	Township number 7	Range number 29
2. Distance and direction from nearest town or city:		3 N 4 E 3/4 N		3. Owner of well: WALTER BRINCY		
Street address of well location if in city:		OF HOODLAND.		R.R. or street: City, state, zip code: HOODLAND, KANSAS		
4. Locate with "X" in section below:		Sketch map:		6. Bore hole dia. 2 1/2 in. Completion date 11-22-75 Well depth 322 ft.		
				7. Cable tool <input type="checkbox"/> Rotary <input type="checkbox"/> Driven <input type="checkbox"/> Dug <input type="checkbox"/> Hollow rod <input type="checkbox"/> Jetted <input type="checkbox"/> Bored <input checked="" type="checkbox"/> Reverse rotary		
5. Type and color of material		From		To		8. Use: Domestic <input type="checkbox"/> Public supply <input type="checkbox"/> Industry <input type="checkbox"/> <input checked="" type="checkbox"/> Irrigation <input type="checkbox"/> Air conditioning <input type="checkbox"/> Stock <input type="checkbox"/> Lawn <input type="checkbox"/> Oil field water <input type="checkbox"/> Other <input type="checkbox"/>
Top Soil		0		3		9. Casing: Material Steel Height: Above or below Threaded <input type="checkbox"/> Welded <input checked="" type="checkbox"/> Surface 8 in. RMP <input type="checkbox"/> PVC <input type="checkbox"/> Weight 322 lbs./ft. Dia. 1 1/2 in. to 322 ft. depth Wall Thickness: inches or Dia. 1 1/2 in. to 322 ft. depth gage No. 1887
Gravel Sandstone & Clay		3		164		10. Screen: Manufacturer's name W. A. BROWN Type Mill Self Dia. 1 1/2 Slot/gauze 1/8 Length 20 Set between 182 ft. and 322 ft. Gravel pack? <input checked="" type="checkbox"/> Size range of material 1/2
Gravel		164		171		11. Static water level: 164 ft. below land surface Date 11-11-75 mo./day/yr.
Sandstone & Clay		171		196		12. Pumping level below land surfaces: 200 ft. after 6 hrs. pumping 900 g.p.m. 250 ft. after 10 hrs. pumping 1140 g.p.m. Estimated maximum yield 11400 g.p.m.
Sand		196		201		13. Water sample submitted: <input type="checkbox"/> Yes <input type="checkbox"/> No Date <input type="checkbox"/> mo./day/yr.
Sandstone & Clay		201		235		14. Well head completion: <input type="checkbox"/> Pitless adapter <input type="checkbox"/> Inches above grade
Sand		235		237		15. Well grouted? <input checked="" type="checkbox"/> With: <input checked="" type="checkbox"/> Neat cement <input type="checkbox"/> Bentonite <input type="checkbox"/> Concrete Depth: From 8' to 10 ft. below
Clay & Sandstone		237		262		16. Nearest source of possible contamination: ft. <input type="checkbox"/> Direction <input type="checkbox"/> Type <input type="checkbox"/> Well disinfected upon completion? <input type="checkbox"/> Yes <input type="checkbox"/> No
Fine Sand		262		264		17. Pump: <input checked="" type="checkbox"/> Not installed Manufacturer's name <input type="checkbox"/> Model number <input type="checkbox"/> HP <input type="checkbox"/> Volts <input type="checkbox"/> Length of drop pipe <input type="checkbox"/> ft. capacity <input type="checkbox"/> g.p.m. Type: <input type="checkbox"/> Submersible <input checked="" type="checkbox"/> Turbine <input type="checkbox"/> Jet <input type="checkbox"/> Reciprocating <input type="checkbox"/> Centrifugal <input type="checkbox"/> Other
Sandstone		264		266		20. Water well contractor's certification: This well was drilled under my jurisdiction and this report is true to the best of my knowledge and belief. Foust Supply Co. Inc. 144 Business name License No. Address Box 338 HOODLAND KANSAS Signed Ralph E. Eganway Date 1-19-76 Authorized representative
Sand		266		304		
Clay		304		311		
Gravel		311		319		
Soapstone		319		321		
Shale		321				
Water Level		164				
18. Elevation:		19. Remarks:		20. Water well contractor's certification:		
Topography: <input type="checkbox"/> Hill <input checked="" type="checkbox"/> Slope <input type="checkbox"/> Upland <input type="checkbox"/> Valley		3601 (TOPO) Cement was run when well was completed.				