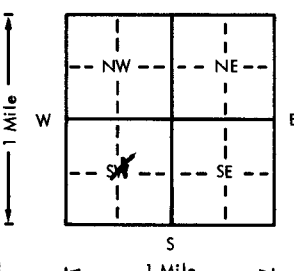
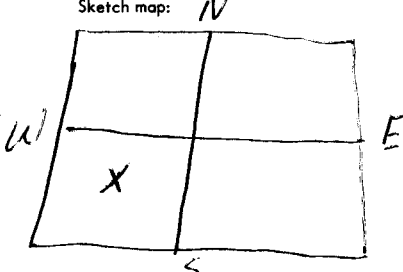


USE TYPEWRITER OR BALL
POINT PEN-PRESS FIRMLY,
PRINT CLEARLY.

WATER WELL RECORD
KSA 82a-1201-1215

Kansas Department of Health and
Environment-Division of Environment
(Water well Contractors)
Topeka, Kansas 66620

1. Location of well:		County SHERMAN	Fraction NE SW 1/4 SW 1/4 SW 1/4	Section number 7	Township number T 7 S R 40 E (W)	Range number
2. Distance and direction from nearest town or city: Street address of well location if in city:		3. Owner of well: R.R. or street: City, state, zip code:		3. Owner of well: W. H. LEONARD 7145 ECHO POOP SAN JOSE CALIF.		
4. Locate with "X" in section below:		Sketch map:		6. Bore hole dia. 26 in. Completion date 1-7-76 Well depth 330 ft.		
				7. Cable tool <input type="checkbox"/> Rotary <input type="checkbox"/> Driven <input type="checkbox"/> Dug <input type="checkbox"/> Hollow rod <input type="checkbox"/> Jetted <input type="checkbox"/> Bored <input checked="" type="checkbox"/> Reverse rotary		
5. Type and color of material		From		To		8. Use: Domestic <input type="checkbox"/> Public supply <input type="checkbox"/> Industry <input checked="" type="checkbox"/> Irrigation <input type="checkbox"/> Air conditioning <input type="checkbox"/> Stock <input type="checkbox"/> Lawn <input type="checkbox"/> Oil field water <input type="checkbox"/> Other
Top Soil		0		2		9. Casing: Material steel Height: Above or below Threaded <input type="checkbox"/> Welded <input checked="" type="checkbox"/> Surface 8 in. RMP <input type="checkbox"/> PVC <input type="checkbox"/> Weight 37 lbs./ft. Dia. 16 in. to 330 ft. depth Wall Thickness: inches or Dia. <input type="checkbox"/> in. to <input type="checkbox"/> ft. depth gage No. 188
Clay Gravel & Sandstone		2		163		10. Screen: Manufacturer's name W. A. Brown Type M. H. SOIT Dia. 16" Slot/gauze 48 Length 30' Set between 188 ft. and 330 ft. ft. and <input type="checkbox"/> ft. Gravel pack? <input checked="" type="checkbox"/> Size range of material 1/2
Gravel		163		167		11. Static water level: <input type="checkbox"/> mo./day/yr. 163 ft. below land surface Date 1-7-76
Sandstone		167		176		12. Pumping level below land surfaces: 185 ft. after 8 hrs. pumping 260 g.p.m. 300 ft. after 16 hrs. pumping 920 g.p.m. Estimated maximum yield 920 g.p.m.
Gravel		176		190		13. Water sample submitted: <input type="checkbox"/> mo./day/yr. Yes <input checked="" type="checkbox"/> No <input type="checkbox"/> Date <input type="checkbox"/>
Clay Gravel & Sandstone		190		243		14. Well head completion: <input type="checkbox"/> Pitless adapter <input type="checkbox"/> inches above grade
Sand		243		265		15. Well grouted? <input checked="" type="checkbox"/> With: <input type="checkbox"/> Neat cement <input type="checkbox"/> Bentonite <input checked="" type="checkbox"/> Concrete Depth: From 10 ft. to 8" X ABOVE
Sandstone		265		270		16. Nearest source of possible contamination: ft. <input type="checkbox"/> Direction <input type="checkbox"/> Type <input type="checkbox"/> Well disinfected upon completion? <input type="checkbox"/> Yes <input type="checkbox"/> No
Sand		270		273		17. Pump: Manufacturer's name AFC TAIT Not installed Model number 12 HCCM HP 125 Volts 460 Length of drop pipe 320 ft. capacity 920 g.p.m. Type: <input type="checkbox"/> Submersible <input checked="" type="checkbox"/> Turbine <input type="checkbox"/> Jet <input type="checkbox"/> Reciprocating <input type="checkbox"/> Centrifugal <input type="checkbox"/> Other
Clay & Sandstone		273		297		20. Water well contractor's certification: This well was drilled under my jurisdiction and this report is true to the best of my knowledge and belief. FOUST Supply Co Inc 144 Business name License No. Address Box 338 Goodland Signed Delph Egan Date 3-31-76 Authorized representative
Sand		297		322		
Soapstone		322		328		
Shale		328		335		
(Use a second sheet if needed)						
18. Elevation:		19. Remarks:		20. Water well contractor's certification:		
Topography: <input checked="" type="checkbox"/> Hill <input checked="" type="checkbox"/> Slope <input type="checkbox"/> Upland <input type="checkbox"/> Valley		3703 (TOD)				