

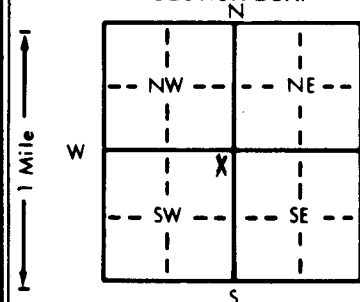
1 LOCATION OF WATER WELL:	Fraction	Section Number	Township Number	Range Number
County: <u>Sherman</u>	<u>NE 1/4 NE 1/4 SW 1/4</u>	<u>20</u>	<u>T 7 S</u>	<u>R 40 E/W</u>

Distance and direction from nearest town or city street address of well if located within city?

6 West 7 North of Goodland, Kansas

2 WATER WELL OWNER:	RR#, St. Address, Box #	Board of Agriculture, Division of Water Resources
<u>Robert Sherman</u>	<u>Goodland Kansas 67735</u>	Application Number:

3 LOCATE WELL'S LOCATION WITH AN "X" IN SECTION BOX:	4 DEPTH OF COMPLETED WELL: <u>235</u> ft. ELEVATION: <u>3600</u>
--	--

Depth(s) Groundwater Encountered 1. 82 ft. 2. . ft. 3. . ft.WELL'S STATIC WATER LEVEL 82 ft. below land surface measured on mo/day/yr May 19 84

Pump test data: Well water was . ft. after . hours pumping . gpm

Est. Yield 20 gpm: Well water was . ft. after . hours pumping . gpmBore Hole Diameter 8 in. to 235 ft., and . in. to . ft.

WELL WATER TO BE USED AS:

1 Domestic 3 Feedlot 6 Oil field water supply 9 Dewatering 12 Other (Specify below)

2 Irrigation 4 Industrial 7 Lawn and garden only 10 Observation well 8 ForWas a chemical/bacteriological sample submitted to Department? Yes. . No. X .; If yes, mo/day/yr sample was sub-mitted Water Well Disinfected? Yes X No

5 TYPE OF BLANK CASING USED:	5 Wrought iron	8 Concrete tile	CASING JOINTS: Glued <u>X</u> Clamped .
1 Steel	3 RMP (SR)	6 Asbestos-Cement	9 Other (specify below)
2 PVC	4 ABS	7 Fiberglass	Welded .
Blank casing diameter <u>5</u> in. to <u>225</u> ft., Dia . in. to . ft., Dia . in. to . ft.			Threaded .

Casing height above land surface 12 in., weight 2.8 lbs./ft. Wall thickness or gauge No. SDR 21

TYPE OF SCREEN OR PERFORATION MATERIAL:	7 PVC	10 Asbestos-cement
1 Steel	3 Stainless steel	5 Fiberglass
2 Brass	4 Galvanized steel	6 Concrete tile
		8 RMP (SR)
		9 ABS
		11 Other (specify)
		12 None used (open hole)

SCREEN OR PERFORATION OPENINGS ARE:	5 Gauzed wrapped	8 Saw cut	11 None (open hole)
1 Continuous slot	6 Wire wrapped	9 Drilled holes	
2 Louvered shutter	7 Torch cut	10 Other (specify)	
4 Key punched			

SCREEN-PERFORATED INTERVALS: From 225 ft. to 235 ft., From . ft. to . ft.

From . ft. to . ft., From . ft. to . ft.

GRAVEL PACK INTERVALS: From 11 ft. to 235 ft., From . ft. to . ft.

From . ft. to . ft., From . ft. to . ft.

From . ft. to . ft., From . ft. to . ft.

7 CONTRACTOR'S OR LANDOWNER'S CERTIFICATION: This water well was (1) <u>constructed</u> (2) reconstructed, or (3) plugged under my jurisdiction and was completed on (mo/day/year) <u>June 14 84</u> and this record is true to the best of my knowledge and belief. Kansas

Water Well Contractor's License No. 184B This Water Well Record was completed on (mo/day/yr) June 18 84under the business name of Schoonridge Drilling Inc by (signature) Robert Sherman

INSTRUCTIONS: Use typewriter or ball point pen, PLEASE PRESS FIRMLY and PRINT clearly. Please fill in blanks, underline or circle the correct answers. Send top

three copies to Kansas Department of Health and Environment, Division of Environment, Environmental Geology Section, Topeka, KS 66620. Send one to WATER WELL

OWNER and retain one for your records.