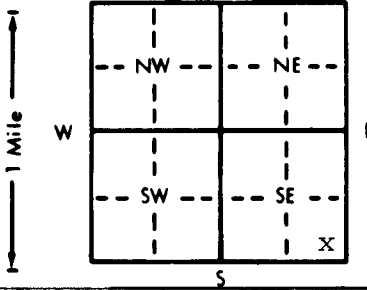


1] LOCATION OF WATER WELL:		Fraction		Section Number		Township Number		Range Number	
County: Sherman		SE 1/4 SE 1/4 SE 1/4		21		T 7 S		R 40 W E/W	
Distance and direction from nearest town or city street address of well if located within city?									
N/A - LOCATION CONFIRMED BY GMD #4									
2] WATER WELL OWNER: Wendell L. & Melba B. Curry									
RR#, St. Address, Box #: Rt 1 Box 28									
City, State, ZIP Code: Goodland, KS 67735									
Board of Agriculture, Division of Water Resources									
Application Number:									
3] LOCATE WELL'S LOCATION WITH AN "X" IN SECTION BOX:					4] DEPTH OF COMPLETED WELL: 120 ft. ELEVATION:				
					Depth(s) Groundwater Encountered 1. ft. 2. ft. 3. ft.				
					WELL'S STATIC WATER LEVEL ft. below land surface measured on mo/day/yr				
					Pump test data: Well water was ft. after hours pumping gpm				
					Est. Yield gpm: Well water was ft. after hours pumping gpm				
					Bore Hole Diameter in. to ft., and in. to ft.				
					WELL WATER TO BE USED AS:				
					5 Public water supply 8 Air conditioning 11 Injection well				
					X1 Domestic 3 Feedlot 6 Oil field water supply 9 Dewatering 12 Other (Specify below)				
					2 Irrigation 4 Industrial 7 Lawn and garden only 10 Monitoring well				
					Was a chemical/bacteriological sample submitted to Department? Yes No; If yes, mo/day/yr sample was submitted				
					Water Well Disinfected? Yes No				
5] TYPE OF BLANK CASING USED:									
X1 Steel 3 RMP (SR) 5 Wrought iron 8 Concrete tile CASING JOINTS: Glued Clamped									
2 PVC 4 ABS 6 Asbestos-Cement 9 Other (specify below) Welded									
7 Fiberglass Threaded									
Blank casing diameter 5 in. to ft., Dia in. to ft., Dia in. to ft.									
Casing height above land surface 12 in., weight lbs./ft. Wall thickness or gauge No.									
TYPE OF SCREEN OR PERFORATION MATERIAL:									
1 Steel 3 Stainless steel 5 Fiberglass 7 PVC 10 Asbestos-cement									
2 Brass 4 Galvanized steel 6 Concrete tile 8 RMP (SR) 11 Other (specify)									
12 None used (open hole)									
SCREEN OR PERFORATION OPENINGS ARE:									
1 Continuous slot 3 Mill slot 5 Gauzed wrapped 8 Saw cut 11 None (open hole)									
2 Louvered shutter 4 Key punched 6 Wire wrapped 9 Drilled holes									
7 Torch cut 10 Other (specify)									
SCREEN-PERFORATED INTERVALS: From ft. to ft., From ft. to ft.									
From ft. to ft., From ft. to ft.									
GRAVEL PACK INTERVALS: From ft. to ft., From ft. to ft.									
From ft. to ft., From ft. to ft.									
6] GROUT MATERIAL: 1 Neat cement 2 Cement grout 3 Bentonite 4 Other									
Grout Intervals: From ft. to ft., From ft. to ft., From ft. to ft.									
What is the nearest source of possible contamination:									
1 Septic tank 4 Lateral lines 7 Pit privy 10 Livestock pens 14 Abandoned water well									
2 Sewer lines 5 Cess pool 8 Sewage lagoon 11 Fuel storage 15 Oil well/Gas well									
3 Watertight sewer lines 6 Seepage pit 9 Feedyard 12 Fertilizer storage 16 Other (specify below)									
13 Insecticide storage									
Direction from well? How many feet?									
FROM TO LITHOLOGIC LOG FROM TO PLUGGING INTERVALS									
ENTER 120 ft Deep									
PLUGGING									
INFORMATION									
AT									
RIGHT									
DIVISION OF ENVIRONMENT									
7] CONTRACTOR'S OR LANDOWNER'S CERTIFICATION: This water well was (1) constructed, (2) reconstructed, or (3) plugged under my jurisdiction and was completed on (mo/day/year) 2-10-90 and this record is true to the best of my knowledge and belief. Kansas Water Well Contractor's License No. This Water Well Record was completed on (mo/day/yr) 2-10-90 under the business name of by (signature) Wendell Curry									