


1 LOCATION OF WATER WELL: Fraction SE 1/4 NW 1/4 SW 1/4 Section Number 35 Township Number T 7 S Range Number R 40 E/W
 County: SHERMAN

Distance and direction from nearest town or city street address of well if located within city?

2 W, 3 NORTH Goodland

2 WATER WELL OWNER: CENTURY FEEDERS Rt 1, Box 30
 RR#, St. Address, Box #: Goodland, KANSAS 67735
 City, State, ZIP Code: Goodland, KANSAS 67735
 Board of Agriculture, Division of Water Resources
 Application Number:

3 LOCATE WELL'S LOCATION WITH AN "X" IN SECTION BOX: 4 DEPTH OF COMPLETED WELL 210' ft. ELEVATION: 3-89

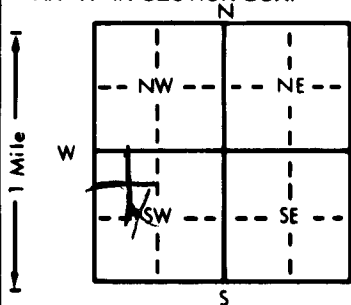






WELL WATER TO BE USED AS: 5 Public water supply 8 Air conditioning 11 Injection well

1 Domestic 3 Feedlot 6 Oil field water supply 9 Dewatering 12 Other (Specify below)

2 Irrigation 4 Industrial 7 Lawn and garden only 10 Observation well

Was a chemical/bacteriological sample submitted to Department? Yes No If yes, mo/day/yr sample was submitted
 Water Well Disinfected? Yes No

5 TYPE OF BLANK CASING USED: 5 Wrought iron 8 Concrete tile CASING JOINTS: Welded Glued Clamped

1 Steel 3 RMP (SR) 6 Asbestos-Cement 9 Other (specify below) Welded

2 PVC 4 ABS 7 Fiberglass Threaded

Blank casing diameter 6 5/8" in. to 170' ft. Dia. 11" in. to 170' ft. Dia. 11" in. to 170' ft.

Casing height above land surface 18" in. weight Industrial P. HESS lbs./ft. Wall thickness or gauge No. 188 3/16"

TYPE OF SCREEN OR PERFORATION MATERIAL: TOP 6' 7 PVC 10 Asbestos-cement

1 Steel 3 Stainless steel 5 Fiberglass 8 RMP (SR) 11 Other (specify)

2 Brass 4 Galvanized steel 6 Concrete tile 9 ABS 12 None used (open hole)

SCREEN OR PERFORATION OPENINGS ARE: 5 Gauzed wrapped 8 Saw cut 11 None (open hole)

1 Continuous slot 3 Mill slot 6 Wire wrapped 9 Drilled holes

2 Louvered shutter 4 Key punched DOERR 7 Torch cut 10 Other (specify)

SCREEN-PERFORATED INTERVALS: From 170-210' ft. to 210' ft. From 170-210' ft. to 210' ft.

GRAVEL PACK INTERVALS: From 30' ft. to 210' ft. From 30' ft. to 210' ft.



6 GROUT MATERIAL: 1 Neat cement 2 Cement grout 3 Bentonite 4 Other

Grout Intervals: From 8' ft. to 30' ft. From 8' ft. to 30' ft.

What is the nearest source of possible contamination: 10 Livestock pens 14 Abandoned water well

1 Septic tank 4 Lateral lines 7 Pit privy 11 Fuel storage 15 Oil well/Gas well

2 Sewer lines 5 Cess pool 8 Sewage lagoon 12 Fertilizer storage 16 Other (specify below)

3 Watertight sewer lines 6 Seepage pit 9 Feedyard 13 Insecticide storage

Direction from well? Surrounding area How many feet? 200'

FROM TO LITHOLOGIC LOG FROM TO LITHOLOGIC LOG

0 20 OVER burden Clay
 20 60 SAND + CLAY
 60 90 GRAVEL + Big Rocks
 90 210 SAND + GRAVEL

7 CONTRACTOR'S OR LANDOWNER'S CERTIFICATION: This water well was (1) constructed, (2) reconstructed, or (3) plugged under my jurisdiction and was completed on (mo/day/year) 3-25-89 and this record is true to the best of my knowledge and belief. Kansas

Water Well Contractor's License No. 484 This Water Well Record was completed on (mo/day/yr) 3-25-89

under the business name of SCHAAF DRILLING by (signature) Walter SchAAF

INSTRUCTIONS: Use typewriter or ball point pen. PLEASE PRESS FIRMLY and PRINT clearly. Please fill in blanks, underline or circle the correct answers. Send top three copies to Kansas Department of Health and Environment, Bureau of Water Protection, Topeka, Kansas 66620-7320, Telephone: 913-862-9360. Send one to WATER WELL OWNER and retain one for your records.

OFFICE USE ONLY

T

R

EW

SEC.

1/4

1/4

1/4

1/4

1/4

1/4