


1 LOCATION OF WATER WELL: County: Sherman Fraction: NW 1/4 SW 1/4 SW 1/4 Section Number: 33 Township Number: T 7 S Range Number: R 42 EW

Distance and direction from nearest town or city street address of well if located within city?  
3 miles north of Kanorado

2 WATER WELL OWNER: Bill Wright  
 RR#, St. Address, Box #: 6858 Rd B  
 City, State, ZIP Code: Kanorado, KS 67741  
 Board of Agriculture, Division of Water Resources  
 Application Number:

3 LOCATE WELL'S LOCATION WITH AN "X" IN SECTION BOX:

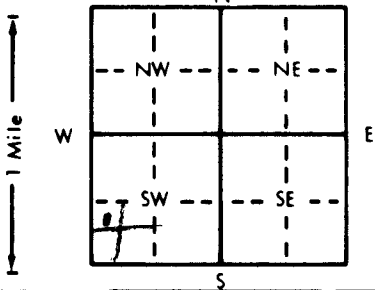

4 DEPTH OF COMPLETED WELL: 290 ft. ELEVATION: ..... ft.  
 Depth(s) Groundwater Encountered 1. 168 ft. 2. .... ft. 3. .... ft.  
 WELL'S STATIC WATER LEVEL ..... 168 ft. below land surface measured on mo/day/yr .....  
 Pump test data: Well water was ..... ft. after ..... hours pumping ..... gpm  
 Est. Yield ..... 20 gpm: Well water was ..... ft. after ..... hours pumping ..... gpm  
 Bore Hole Diameter ..... 8 in. to ..... 290 ft., and ..... in. to ..... ft.  
 WELL WATER TO BE USED AS:  
 1 Domestic     3 Feedlot     6 Oil field water supply     9 Dewatering     12 Other (Specify below)  
 2 Irrigation     4 Industrial     7 Lawn and garden only     10 Monitoring well  
 Was a chemical/bacteriological sample submitted to Department? Yes.....No.  .....; If yes, mo/day/yr sample was submitted  
 Water Well Disinfected? Yes  No

5 TYPE OF BLANK CASING USED:  
 1 Steel     3 RMP (SR)     6 Asbestos-Cement     9 Other (specify below)  
 2 PVC     4 ABS     7 Fiberglass  
 Blank casing diameter ..... 4.5 in. to ..... 250 ft., Dia ..... in. to ..... ft., Dia ..... in. to ..... ft.  
 Casing height above land surface ..... 12 in., weight ..... 160 lbs./ft. Wall thickness or gauge No. SDR 26

TYPE OF SCREEN OR PERFORATION MATERIAL:  
 1 Steel     3 Stainless steel     5 Fiberglass     7 PVC     10 Asbestos-cement  
 2 Brass     4 Galvanized steel     6 Concrete tile     8 RMP (SR)     11 Other (specify) .....  
 12 None used (open hole)

SCREEN OR PERFORATION OPENINGS ARE:  
 1 Continuous slot     3 Mill slot     5 Gauzed wrapped     8 Saw cut     11 None (open hole)  
 2 Louvered shutter     4 Key punched     6 Wire wrapped     9 Drilled holes

SCREEN-PERFORATED INTERVALS: From ..... 250 ft. to ..... 290 ft. From ..... ft. to ..... ft.  
 From ..... ft. to ..... ft. From ..... ft. to ..... ft.  
 GRAVEL PACK INTERVALS: From ..... 230 ft. to ..... 290 ft. From ..... ft. to ..... ft.  
 From ..... 20 ft. to ..... 230 ft. From ..... ft. to ..... ft.

6 GROUT MATERIAL:  1 Neat cement     2 Cement grout     3 Bentonite     4 Other .....  
 Grout intervals: From ..... 0 ft. to ..... 20 ft., From ..... ft. to ..... ft., From ..... ft. to ..... ft.

What is the nearest source of possible contamination: None in view  
 1 Septic tank     4 Lateral lines     7 Pit privy     10 Livestock pens     14 Abandoned water well  
 2 Sewer lines     5 Cess pool     8 Sewage lagoon     11 Fuel storage     15 Oil well/Gas well  
 3 Watertight sewer lines     6 Seepage pit     9 Feedyard     12 Fertilizer storage     16 Other (specify below)  
 13 Insecticide storage

Direction from well? How many feet?

FROM	TO	LITHOLOGIC LOG	FROM	TO	PLUGGING INTERVALS
0	60	Clay			
60	100	gravel			
100	120	Sand + clay			
120	140	gravel + sand			
140	160	sand + clay			
160	180	sandstone - sand + clay			
180	200	sand + clay			
200	220	sand + clay			
220	240	sand sand clay			
240	287	fine to medium sand			
287	290	shale			

7 CONTRACTOR'S OR LANDOWNER'S CERTIFICATION: This water well was  (1) constructed  (2) reconstructed, or  (3) plugged under my jurisdiction and was completed on (mo/day/year) ..... 6-5-98 ..... and this record is true to the best of my knowledge and belief, Kansas Water Well Contractor's License No. 484 ..... This Water Well Record was completed on (mo/day/yr) ..... 6-19-98 ..... under the business name of Schaal Sinking Co. by (signature) [Signature]

INSTRUCTIONS: Use typewriter or ball point pen. PLEASE PRESS FIRMLY and PRINT clearly. Please fill in blanks, underline or circle the correct answers. Send top three copies to Kansas Department of Health and Environment, Bureau of Water, Topeka, Kansas 66620-0001. Telephone: 913-296-5545. Send one to WATER WELL OWNER and retain one for your records.