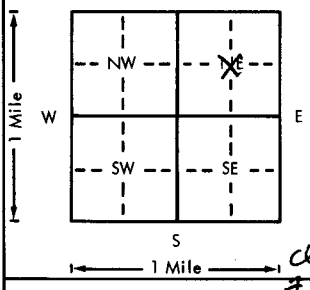


USE TYPEWRITER OR BALL
POINT PEN-PRESS FIRMLY,
PRINT CLEARLY.

WATER WELL RECORD
KSA 82a-1201-1215

Kansas Department of Health and
Environment-Division of Environment
(Water well Contractors)
Topeka, Kansas 66620

ACA

1. Location of well:		County SHERMAN	Fraction 1/4 C 1/4 NE 1/4	Section number 1	Township number T 7 S	Range number R 41 E																																				
2. Distance and direction from nearest town or city: Goodland Street address of well location if in city: 5 W 9 N 1/4 WMS				3. Owner of well: Robert Henry R.R. or street: R.R. 3 City, state, zip code: Goodland Kansas 67735																																						
4. Locate with "X" in section below: Sketch map: 				6. Bore hole dia. 26 in. Completion date Well depth 335 ft. 4-7-77																																						
5. Type and color of material <table border="1"><thead><tr><th></th><th>From</th><th>To</th></tr></thead><tbody><tr><td>FINE SAND, M GRAVEL, SANDSTONE</td><td>161</td><td>232</td></tr><tr><td>FINE SAND, SANDY CLAY</td><td>232</td><td>243</td></tr><tr><td>SANDSTONE</td><td>243</td><td>249</td></tr><tr><td>FINE SAND, SANDY CLAY</td><td>249</td><td>283</td></tr><tr><td>SANDY CLAY, SANDSTONE</td><td>283</td><td>291</td></tr><tr><td>SANDSTONE</td><td>291</td><td>299</td></tr><tr><td>FINE SAND, SANDY CLAY</td><td>299</td><td>310</td></tr><tr><td>FINE SAND</td><td>310</td><td>325</td></tr><tr><td>M GRAVEL</td><td>325</td><td>329</td></tr><tr><td>Other</td><td>329</td><td>335</td></tr><tr><td colspan="3">BRICK 325'</td></tr>Cable tool <input type="checkbox"/> Rotary <input type="checkbox"/> Driven <input type="checkbox"/> Dug <input type="checkbox"/> Hollow rod <input type="checkbox"/> Jetted <input type="checkbox"/> Bored <input checked="" type="checkbox"/> Reverse rotary		
8. Use: <input type="checkbox"/> Domestic <input type="checkbox"/> Public supply <input type="checkbox"/> Industry <input checked="" type="checkbox"/> Irrigation <input type="checkbox"/> Air conditioning <input type="checkbox"/> Stock <input type="checkbox"/> Lawn <input type="checkbox"/> Oil field water <input type="checkbox"/> Other				9. Casing: Material STEEL Height: Above or below Threaded <input type="checkbox"/> Welded <input checked="" type="checkbox"/> Surface 12 in. RMP <input type="checkbox"/> PVC <input type="checkbox"/> Weight 86 lbs./ft. Dia. 16 in. to 22.5 ft. depth Wall Thickness: inches or Dia. <input type="checkbox"/> in. to <input type="checkbox"/> ft. depth gage No. 219																																						
10. Screen: Manufacturer's name W.A. BROWN Type LOWYER Dia. 16 Slot/gauze 1/8 X 7 Length 110 Set between 22.5 ft. and 23.5 ft. Gravel pack? YES Size range of material 1/4 X 3/8				11. Static water level: <input type="checkbox"/> mo./day/yr. 166 ft. below land surface Date 2-15-77																																						
12. Pumping level below land surfaces: 280 ft. after 4 hrs. pumping 1200 g.p.m. ____ ft. after ____ hrs. pumping ____ g.p.m. Estimated maximum yield 1400 g.p.m.				13. Water sample submitted: <input type="checkbox"/> mo./day/yr. Yes <input checked="" type="checkbox"/> No Date																																						
14. Well head completion: <input type="checkbox"/> Pitless adapter <input type="checkbox"/> Inches above grade				15. Well grouted? YES With: <input type="checkbox"/> Neat cement <input type="checkbox"/> Bentonite <input checked="" type="checkbox"/> Concrete Depth: From 0 ft. to 10 ft.																																						
16. Nearest source of possible contamination: ft. ____ Direction ____ Type NONE Well disinfected upon completion? <input type="checkbox"/> Yes <input checked="" type="checkbox"/> No				17. Pump: <input type="checkbox"/> Not installed Manufacturer's name WESTERN LARD ROLLER Model number 8M HP 100 Volts Length of drop pipe 320 ft. capacity 1200 g.p.m. Type: <input type="checkbox"/> Submersible <input checked="" type="checkbox"/> Turbine <input type="checkbox"/> Jet <input type="checkbox"/> Reciprocating <input type="checkbox"/> Centrifugal <input type="checkbox"/> Other																																						
18. Elevation:				19. Remarks:																																						
Topography: <input type="checkbox"/> Hill <input type="checkbox"/> Slope <input checked="" type="checkbox"/> Upland <input type="checkbox"/> Valley				20. Water well contractor's certification: This well was drilled under my jurisdiction and this report is true to the best of my knowledge and belief. STH Drilling Co Inc 166 Business name License No. Address Goodland Kansas Signed Bill Clifford Date 4-8-77 Authorized representative																																						