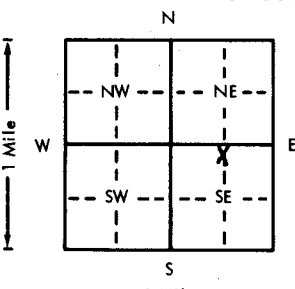
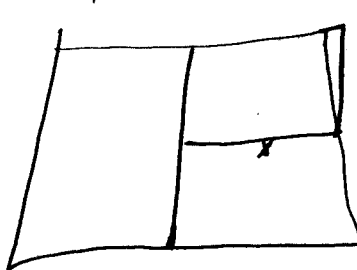


USE TYPEWRITER OR BALL  
POINT PEN—PRESS FIRMLY,  
PRINT CLEARLY.

DBA  
NE NW SE  
WATER WELL RECORD  
KSA 82a-1201-1215

Kansas Department of Health and  
Environment—Division of Environment  
(Water well Contractors)  
Topeka, Kansas 66620

1. Location of well:		County <b>SHERMAN</b>	Fraction <b>SE 1/4 E 1/4</b>	Section number <b>12</b>	Township number <b>T 7 S</b>	Range number <b>R 41 E</b>
2. Distance and direction from nearest town or city:  Street address of well location if in city:				3. Owner of well: <b>Frank. Liboe</b> R.R. or street: City, state, zip code: <b>SAN JOSE, CAL.</b>		
4. Locate with "X" in section below:		Sketch map:		6. Bore hole dia. <b>3 1/2</b> in. Completion date <b>2-23-76</b> Well depth <b>317</b> ft.		
				7. Cable tool <input type="checkbox"/> Rotary <input type="checkbox"/> Driven <input type="checkbox"/> Dug <input type="checkbox"/> Hollow rod <input type="checkbox"/> Jetted <input type="checkbox"/> Bored <input checked="" type="checkbox"/> Reverse rotary		
5. Type and color of material				8. Use: Domestic <input type="checkbox"/> Public supply <input type="checkbox"/> Industry <input checked="" type="checkbox"/> Irrigation <input type="checkbox"/> Air conditioning <input type="checkbox"/> Stock <input type="checkbox"/> Lawn <input type="checkbox"/> Oil field water <input type="checkbox"/> Other		
Topsoil				9. Casing: Material <b>Steel</b> Height: <b>Above</b> or below Threaded <input type="checkbox"/> Welded <input checked="" type="checkbox"/> Surface <b>8</b> in. RMP <input type="checkbox"/> PVC <input type="checkbox"/> Weight <b>42</b> lbs./ft. Dia. <b>8</b> in. to <b>317</b> ft. depth Wall Thickness: inches or Dia. <input type="checkbox"/> in. to <input type="checkbox"/> ft. depth gage No. <b>217</b>		
Gravel -- Clay				10. Screen: Manufacturer's name <b>W.A. Brown</b> Type <b>Millslot</b> Dia. <b>1 1/2</b> Slot/gauze <b>1/8</b> Length <b>120</b> Set between <b>197</b> ft. and <b>317</b> ft. Gravel pack? <input checked="" type="checkbox"/> Size range of material <b>1/2</b>		
Sandstone --- Gravel				11. Static water level: <b>147</b> ft. below land surface Date <b>2-13-76</b>		
Gravel Water level				12. Pumping level below land surfaces: <b>260</b> ft. after <b>8</b> hrs. pumping <b>800</b> g.p.m. <b>280</b> ft. after <b>16</b> hrs. pumping <b>1280</b> g.p.m. Estimated maximum yield <b>1280</b> g.p.m.		
Clay				13. Water sample submitted: <input type="checkbox"/> Yes <input checked="" type="checkbox"/> No Date		
Sand				14. Well head completion: <input type="checkbox"/> Pitless adapter <input type="checkbox"/> Inches above grade		
Sandstone -- Clay				15. Well grouted? <input checked="" type="checkbox"/> With: <input type="checkbox"/> Neat cement <input checked="" type="checkbox"/> Bentonite <input type="checkbox"/> Concrete Depth: From <b>2' below</b> to <b>10</b> ft. <b>Below</b>		
Fine Sand				16. Nearest source of possible contamination: ft. Direction Type Well disinfected upon completion? <input type="checkbox"/> Yes <input type="checkbox"/> No		
Sandstone				17. Pump: Not installed Manufacturer's name <b>TAIT AYC</b> Model number <b>1244</b> HP Volts Length of drop pipe <b>300</b> ft. capacity <b>1280</b> g.p.m. Type: <input type="checkbox"/> Submersible <input checked="" type="checkbox"/> Turbine <input type="checkbox"/> Jet <input type="checkbox"/> Reciprocating <input type="checkbox"/> Centrifugal <input type="checkbox"/> Other		
Sand				20. Water well contractor's certification: This well was drilled under my jurisdiction and this report is true to the best of my knowledge and belief. <b>1414</b> <b>Forest Supply Co Inc</b> Business name License No. Address <b>Box 338 Goodland</b> Signed <b>Ralph Elman</b> Date <b>6-15-76</b> Authorized representative		
Gravel						
Soapstone						
Shale						
EROCK 310						
(Use a second sheet if needed)						
18. Elevation:		19. Remarks: <b>3711 (TOTO)</b>				
Topography: <input checked="" type="checkbox"/> Hill <input type="checkbox"/> Slope <input type="checkbox"/> Upland <input type="checkbox"/> Valley						