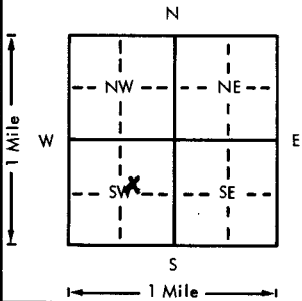


USE TYPEWRITER OR BALL  
POINT PEN-PRESS FIRMLY,  
PRINT CLEARLY.

WATER WELL RECORD  
KSA 82a-1201-1215

Kansas Department of Health and  
Environment-Division of Environment  
(Water well Contractors)  
Topeka, Kansas 66620

1. Location of well:		County <b>SHERMAN</b>	Fraction <b>SW 1/4 NE 1/4 SW 1/4</b>	Section number <b>22</b>	Township number <b>T 7 S R 41 E/W</b>	Range number
2. Distance and direction from nearest town or city: <b>Ruleton</b> Street address of well location if in city: <b>6 1/4 N 1/4 E</b>				3. Owner of well: <b>John Boyington</b> R.R. or street: <b>R.R 2 Box 690</b> City, state, zip code: <b>Goodland Kansas 67735</b>		
4. Locate with "X" in section below:		Sketch map:		6. Bore hole dia. <b>2</b> in. Completion date Well depth <b>223</b> ft. <b>12-28-76</b>		
				7. <input type="checkbox"/> Cable tool <input checked="" type="checkbox"/> Rotary <input type="checkbox"/> Driven <input type="checkbox"/> Dug <input type="checkbox"/> Hollow rod <input type="checkbox"/> Jetted <input type="checkbox"/> Bored <input type="checkbox"/> Reverse rotary		
5. Type and color of material		From	To	8. Use: <input type="checkbox"/> Domestic <input type="checkbox"/> Public supply <input type="checkbox"/> Industry <input type="checkbox"/> Irrigation <input type="checkbox"/> Air conditioning <input checked="" type="checkbox"/> Stock <input type="checkbox"/> Lawn <input type="checkbox"/> Oil field water <input type="checkbox"/> Other		
<b>M GRAVEL, SANDY CLAY</b>		<b>70</b>	<b>109</b>	9. Casing: Material <b>PLAST</b> Height: Above or below Threaded <input type="checkbox"/> Welded <input type="checkbox"/> Surface <b>12</b> in. RMP <input type="checkbox"/> PVC <input checked="" type="checkbox"/> Weight <input type="checkbox"/> lbs./ft. Dia. <b>4</b> in. to <b>213</b> ft. depth Wall Thickness: inches or Dia. <input type="checkbox"/> in. to <input type="checkbox"/> ft. depth gage No. <b>200</b>		
<b>FINE SAND, CLAY, SANDSTONE</b>		<b>109</b>	<b>143</b>	10. Screen: Manufacturer's name <b>WESS &amp; LOWELL</b> Type <b>LOUVER</b> Dia. <b>5"</b> Slot/gauze <b>1/8 200</b> Length <b>20</b> Set between <b>213</b> ft. and <b>223</b> ft. <input type="checkbox"/> ft. and <input type="checkbox"/> ft. Gravel pack? <b>YES</b> Size range of material <b>1/8</b>		
<b>M GRAVEL, TRAC CLAY</b>		<b>143</b>	<b>148</b>	11. Static water level: <input type="checkbox"/> mo./day/yr. <b>77</b> ft. below land surface Date <b>12-21-76</b>		
<b>SANDSTONE</b>		<b>148</b>	<b>159</b>	12. Pumping level below land surfaces: <b>107</b> ft. after <b>3</b> hrs. pumping <b>20</b> g.p.m. <input type="checkbox"/> ft. after <input type="checkbox"/> hrs. pumping <input type="checkbox"/> g.p.m. Estimated maximum yield <b>50</b> g.p.m.		
<b>FINE SAND, SANDSTONE</b>		<b>159</b>	<b>178</b>	13. Water sample submitted: <input type="checkbox"/> mo./day/yr. <input type="checkbox"/> Yes <input checked="" type="checkbox"/> No Date <input type="checkbox"/>		
<b>SANDY CLAY, SANDSTONE</b>		<b>178</b>	<b>181</b>	14. Well head completion: <input type="checkbox"/> Pitless adapter <input type="checkbox"/> Inches above grade		
<b>FINE SAND SANDY CLAY</b>		<b>181</b>	<b>207</b>	15. Well grouted? <b>YES</b> With: <input type="checkbox"/> Neat cement <input type="checkbox"/> Bentonite <input checked="" type="checkbox"/> Concrete Depth: From <b>0</b> ft. to <b>10</b> ft.		
<b>SANDY CLAY, SANDSTONE</b>		<b>207</b>	<b>212</b>	16. Nearest source of possible contamination: ft. <input type="checkbox"/> Direction <input type="checkbox"/> Type <b>PASTURE</b> Well disinfected upon completion? <input checked="" type="checkbox"/> Yes <input type="checkbox"/> No		
<b>FINE SAND, SANDSTONE</b>		<b>212</b>	<b>223</b>	17. Pump: <input checked="" type="checkbox"/> Not installed Manufacturer's name <input type="checkbox"/> Model number <input type="checkbox"/> HP <input type="checkbox"/> Volts <input type="checkbox"/> Length of drop pipe <input type="checkbox"/> ft. capacity <input type="checkbox"/> g.p.m. Type: <input type="checkbox"/> Submersible <input type="checkbox"/> Turbine <input type="checkbox"/> Jet <input type="checkbox"/> Reciprocating <input type="checkbox"/> Centrifugal <input type="checkbox"/> Other		
<b>SANDSTONE</b>		<b>223</b>	<b>227</b>	20. Water well contractor's certification: This well was drilled under my jurisdiction and this report is true to the best of my knowledge and belief. <b>S &amp; H Drilling Co Inc. 166</b> Business name <b>Goodland Kan.</b> License No. Address <b>Bill Clifford</b> Signed <b>12-28-76</b> Date		
<b>FINE SAND, SANDY CLAY</b>		<b>227</b>	<b>233</b>			
(Use a second sheet if needed)						
18. Elevation:		19. Remarks:		20. Water well contractor's certification:		
Topography: <input type="checkbox"/> Hill <input type="checkbox"/> Slope <input checked="" type="checkbox"/> Upland <input type="checkbox"/> Valley		<b>3725 (TOTO)</b>		<b>S &amp; H Drilling Co Inc. 166</b> Business name <b>Goodland Kan.</b> License No. Address <b>Bill Clifford</b> Signed <b>12-28-76</b> Date		