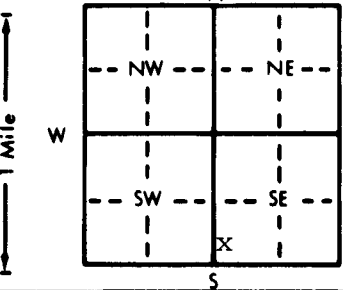


1 LOCATION OF WATER WELL:		Fraction		Section Number	Township Number	Range Number
County: <u>Sherman</u>		SW 1/4 SW 1/4 SE 1/4		24	T 7 S	R 41 W E/W
Distance and direction from nearest town or city street address of well if located within city?						
N/A - LOCATION CONFIRMED BY GMD #4						
2 WATER WELL OWNER: <u>Elna Mae Dickey Etal</u>						
RR#, St. Address, Box # : <u>1537 Main</u>						
City, State, ZIP Code : <u>Goodland, KS 67735</u>						
Board of Agriculture, Division of Water Resources						
Application Number:						
3 LOCATE WELL'S LOCATION WITH AN "X" IN SECTION BOX:		4 DEPTH OF COMPLETED WELL <u>UNK</u> ft. ELEVATION:				
		Depth(s) Groundwater Encountered 1. ft. 2. ft. 3. ft.				
		WELL'S STATIC WATER LEVEL <u>UNK</u> ft. below land surface measured on mo/day/yr				
		Pump test data: Well water was ft. after hours pumping gpm				
		Est. Yield gpm: Well water was ft. after hours pumping gpm				
		Bore Hole Diameter in. to ft., and in. to ft.				
		WELL WATER TO BE USED AS:				
		5 Public water supply 8 Air conditioning 11 Injection well				
		X1 Domestic 3 Feedlot 6 Oil field water supply 9 Dewatering 12 Other (Specify below)				
		2 Irrigation 4 Industrial 7 Lawn and garden only 10 Monitoring well				
		Was a chemical/bacteriological sample submitted to Department? Yes.....No.....; If yes, mo/day/yr sample was submitted				
		Water Well Disinfected? Yes No				
5 TYPE OF BLANK CASING USED:						
X1 Steel 3 RMP (SR) 5 Wrought iron 8 Concrete tile CASING JOINTS: Glued Clamped						
2 PVC 4 ABS 6 Asbestos-Cement 9 Other (specify below) Welded						
7 Fiberglass Threaded						
Blank casing diameter 5 in. to ft., Dia in. to ft., Dia in. to ft.						
Casing height above land surface 0 in., weight lbs./ft. Wall thickness or gauge No.						
TYPE OF SCREEN OR PERFORATION MATERIAL:						
1 Steel 3 Stainless steel 5 Fiberglass 8 RMP (SR) 10 Asbestos-cement						
2 Brass 4 Galvanized steel 6 Concrete tile 9 ABS 11 Other (specify)						
12 None used (open hole)						
SCREEN OR PERFORATION OPENINGS ARE:						
5 Gauzed wrapped 8 Saw cut 11 None (open hole)						
1 Continuous slot 3 Mill slot 6 Wire wrapped 9 Drilled holes						
2 Louvered shutter 4 Key punched 7 Torch cut 10 Other (specify)						
SCREEN-PERFORATED INTERVALS: From ft. to ft., From ft. to ft.						
From ft. to ft., From ft. to ft.						
GRAVEL PACK INTERVALS: From ft. to ft., From ft. to ft.						
From ft. to ft., From ft. to ft.						
6 GROUT MATERIAL: 1 Neat cement 2 Cement grout 3 Bentonite 4 Other						
Grout Intervals: From 9 ft. to 0 ft., From ft. to ft., From ft. to ft.						
What is the nearest source of possible contamination:						
1 Septic tank 4 Lateral lines 7 Pit privy 10 Livestock pens 14 Abandoned water well						
2 Sewer lines 5 Cess pool 8 Sewage lagoon 11 Fuel storage 15 Oil well/Gas well						
3 Watertight sewer lines 6 Seepage pit 9 Feedyard 12 Fertilizer storage 16 Other (specify below)						
13 Insecticide storage CREEK						
Direction from well? How many feet?						
FROM	TO	LITHOLOGIC LOG	FROM	TO	PLUGGING INTERVALS	
	ENTER				BELOW 15' BELOW COLLAPSED SAND	
		PLUGGING	15	9		
			9	0		
		INFORMATION				
		AT				
		RIGHT				
7 CONTRACTOR'S OR LANDOWNER'S CERTIFICATION: This water well was (1) constructed, (2) reconstructed, or (3) plugged under my jurisdiction and was completed on (mo/day/year) <u>Dec. 30, 1989</u> and this record is true to the best of my knowledge and belief. Kansas Water Well Contractor's License No. This Water Well Record was completed on (mo/day/yr) <u>Jan 6, 1991</u> under the business name of by (signature) <u>Elna Mae Dickey</u>						
GOODY'S OF GOODLAND. PLUGGED THE WELL.						

OFFICE USE ONLY

T

R

EW

SEC.

1/4

1/4

1/4