

USE TYPEWRITER OR BALL POINT PEN-PRESS FIRMLY, PRINT CLEARLY.


WATER WELL RECORD
KSA 82a-1201-1215

Kansas Department of Health and Environment-Division of Environment (Water well Contractors) Topeka, Kansas 66620

BAC BOB

1. Location of well: County Sherman Fraction SW 1/4 NE 1/4 N. 1/2 W. 1/4 Section number 31 Township number T 7 S R 41 E W Range number 41

2. Distance and direction from nearest town or city: 3 N 3 W 2 1/2 W 3. Owner of well: Karl O. Ramstetter
Street address of well location if in city: 6 F Ruleton Kans R.R. or street: 1301 19 St.
City, state, zip code: Golden Colorado 80401

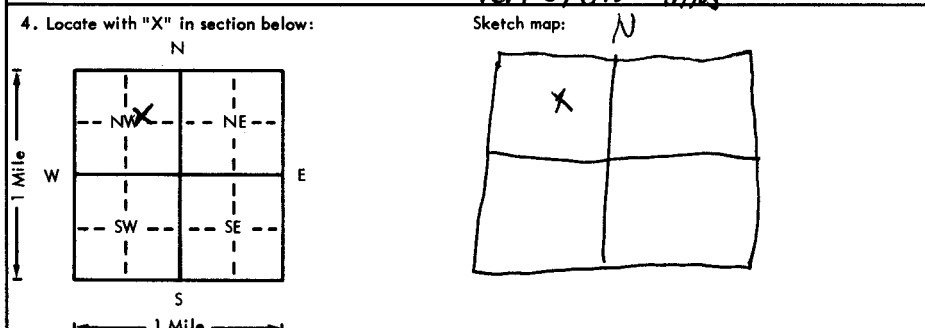


6. Bore hole dia. 24 in. Completion date: 9-1-77
Well depth: 292 ft.
7. Cable tool Rotary Driven Dug
 Hollow rod Jetted Bored Reverse rotary
8. Use: Domestic Public supply Industry
 Irrigation Air conditioning Stock
 Lawn Oil field water Other
9. Casing: Material Steel Height: Above or below
Threaded Welded Surface 8 in.
RMP PVC Weight 27 lbs./ft.
Dia. 8 in. to 172 ft. depth Wall Thickness: inches or
Dia. 8 in. to 172 ft. depth gage No. 188

| 5. Type and color of material | From | To |
|------------------------------------|------------|------------|
| <u>Clay Gravel & Sandstone</u> | <u>0</u> | <u>119</u> |
| <u>Gravel</u> | <u>119</u> | <u>126</u> |
| <u>Sandy clay</u> | <u>126</u> | <u>137</u> |
| <u>Gravel</u> | <u>137</u> | <u>160</u> |
| <u>Clay & Sandstone</u> | <u>160</u> | <u>201</u> |
| <u>Gravel</u> | <u>201</u> | <u>203</u> |
| <u>Joint Clay & Sandstone</u> | <u>203</u> | <u>210</u> |
| <u>Gravel</u> | <u>210</u> | <u>217</u> |
| <u>Sandstone & Clay</u> | <u>217</u> | <u>259</u> |
| <u>Sand</u> | <u>259</u> | <u>267</u> |
| <u>Sandy clay & Sandstone</u> | <u>267</u> | <u>279</u> |
| <u>Gravel</u> | <u>279</u> | <u>281</u> |
| <u>Soapstone</u> | <u>281</u> | <u>288</u> |
| <u>Shale</u> | <u>288</u> | <u>295</u> |

10. Screen: Manufacturer's name W.A.B. Rand
Type Mill salt Dia. 16
Slot/gauze 1/8 Length 120'
Set between 172 ft. and 292 ft.
Gravel pack? Size range of material 1/2
11. Static water level: 119 ft. below land surface Date 2-5-77 mo./day/yr.
12. Pumping level below land surfaces:
190 ft. after 6 hrs. pumping 600 g.p.m.
280 ft. after 16 hrs. pumping 618 g.p.m.
Estimated maximum yield 618 g.p.m.
13. Water sample submitted: None mo./day/yr.
 Yes No Date _____
14. Well head completion: None Pitless cap? None Inches above grade
15. Well grouted? With: Neat cement Bentonite Concrete
Depth: From 8" head to 10 ft. Below
16. Nearest source of possible contamination: None ft. Direction None Type _____
Well disinfected upon completion? Yes No
17. Pump: Not installed
Manufacturer's name HAIT A/C Pump
Model number 462017 HP 7.5 Volts _____
Length of drop pipe 280 ft. capacity 618 g.p.m.
Type: Submersible Turbine
 Jet Reciprocating
 Centrifugal Other

18. Elevation: _____
19. Remarks: 3500
Concess Run By
Foust Supply Co Inc.

20. Water well contractor's certification:
This well was drilled under my jurisdiction and this report is true to the best of my knowledge and belief.
Foust Supply Co Inc 144
Business name _____ License No. _____
Address 44328 Goddard Kan
Signed Deft Eblan mgr Date 5-6-77
Authorized representative

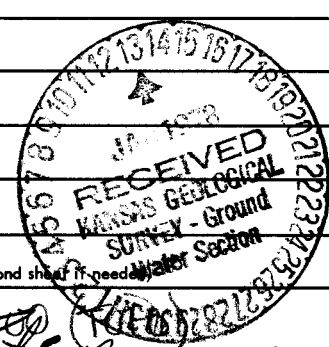

7 41 E 3 L SW NE NW Sec 1/4 1/4 1/4 1/4