


1	LOCATION OF WATER WELL:	Fraction	Section Number	Township Number	Range Number
County:	SHERMAN	NW ¼ SE ¼ NW ¼	11	7S	42W XXW

Distance and direction from nearest town or city street address of well if located within city?

2 WATER WELL OWNER: JAMES FRITZ
 RR #, St. Address, Box #: 7102 ROAD 8
 City, State, ZIP Code : GOODLAND KS 67735
 Board of Agriculture, Division of Water Resources
 Application Number: 13,377

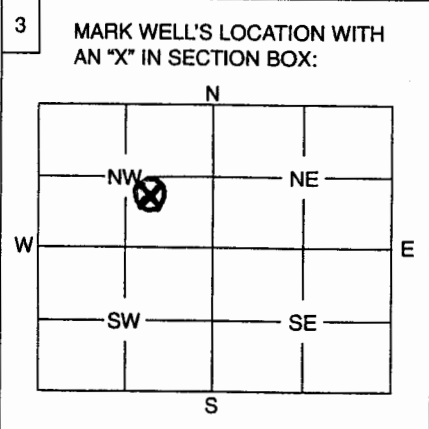

4 DEPTH OF WELL 326 ft.
 WELL'S STATIC WATER LEVEL 178 ft.
 WELL WAS USED AS:

1 Domestic	5 Public Water Supply	9 Dewatering
2 Irrigation	6 Oil Field Water Supply	10 Monitoring Well
3 Feedlot	7 Domestic (Lawn & Garden)	11 Injection Well
4 Industrial	8 Air Conditioning	12 Other

Was a chemical / bacteriological sample submitted to Department? Yes No XX.....
 If yes, mo/day/yr sample was submitted

Water Well Disinfected: Yes XX... No HTH

5 TYPE OF BLANK CASING USED:

1 Steel	3 RMP (SR)	5 Wrought	7 Fiberglass	9 Other (Specify below)
2 PVC	4 ABS	6 Asbestos-Cement	8 Concrete Tile

Blank casing diameter 16 in. Was casing pulled? Yes XX..... No If yes, how much 8'
 Casing height above or below land surface 8' BELOW in.

6 GROUT PLUG MATERIAL: 1 Neat cement 2 Cement grout 3 Bentonite 4 Other

Grout Plug Intervals: From 175 ft. to 180 ft., From ft. to ft., From 8 to 6 ft.

What is the nearest source of possible contamination:

1 Septic tank	6 Seepage pit	11 Fuel storage	16 Other (specify below)
2 Sewer lines	7 Pit privy	12 Fertilizer storage
3 Watertight sewer lines	8 Sewage lagoon	13 Insecticide storage
4 Lateral lines	9 Feedyard	14 Abandoned water well
5 Cess pool	10 Livestock pens	15 Oil well/Gas well (CAPPED)

Direction from well? SW How many feet? 300'

FROM	TO	PLUGGING MATERIALS
326'	175'	CHLORINATED GRAVEL
175'	180'	BENTONITE CHIPS
180'	8'	NATIVE CLAYS
8'		1/4" STEEL PLATE WELDED SOLID TO CASING
8'	6'	BENTONITE PACKED OVER CASING
6'	0	NATIVE CLAYS PACKED TO SURFACE

7 CONTRACTOR'S OF LANDOWNER'S CERTIFICATION: This water well was plugged under my jurisdiction and was completed on (mo/day/year) 6-21-2007 and this record is true to the best of my knowledge and belief. Kansas Water Well Contractor's License No. 633 This Water Well Record was completed on (mo/day/year) 8-4-2007 under the business name of DMW WELL & PUMP SERVICE by (signature) James T. Howard

INSTRUCTIONS: Use typewriter or ball point pen. Please press firmly and print clearly. Please fill in blanks, underline or circle the correct answers. Send top three copies to Kansas Department of Health and Environment, Bureau of Water, Geology Section, 1000 SW Jackson St., Ste. 420, Topeka, Kansas 66612-1367. Telephone: 785/296-5522. Send one to Water Well Owner and retain one for your records.