

USE TYPEWRITER OR BALL POINT PEN-PRESS FIRMLY, PRINT CLEARLY.

RULE 701

T R EW sec 1/4 1/4 1/4 No.


WATER WELL RECORD
KSA 82a-1201-1215

Kansas State Dept. Of Health
(Water Well Contractors)
Forbes-Bldg. 740
Topeka, Kansas 66620

ABD
SE NW NE

1 Location of well:	County Sherman	Township name GRANT	Fraction NW 1/4 NE 1/4	Section number 14	Town number 7	Range number 7 1/2 W
---------------------	--------------------------	-------------------------------	----------------------------------	-----------------------------	-------------------------	--------------------------------

Distance and direction from nearest town or city: Street address of well location if in city: 7N-4W Rulton	3 Owner of well: Address: Harold Bair 526 7th Ave Goodland, Kans 67735
---	------------------------------------------------------------------------------------------

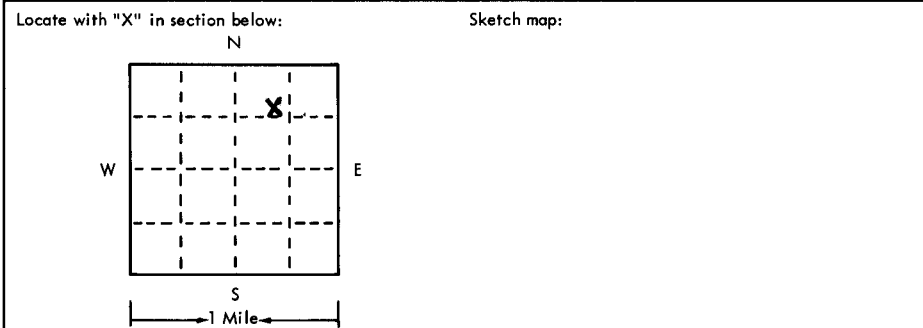

4 Well depth: 325 ft. Date of completion 4-20-75 Well diameter 30 in.
5 <input type="checkbox"/> Cable tool <input type="checkbox"/> Rotary <input type="checkbox"/> Driven <input type="checkbox"/> Dug <input type="checkbox"/> Hollow rod <input type="checkbox"/> Jetted <input type="checkbox"/> Bored <input checked="" type="checkbox"/> Reverse rotary
6 Use: <input type="checkbox"/> Domestic <input type="checkbox"/> Public supply <input type="checkbox"/> Industry <input checked="" type="checkbox"/> Irrigation <input type="checkbox"/> Air conditioning <input type="checkbox"/> Commercial <input type="checkbox"/> Test well
7 Casing: Material Steel Height: above MNC Threaded <input type="checkbox"/> Welded <input checked="" type="checkbox"/> Surface 12 in. Diam. 10 in. to 325 ft. depth Drive shoe? <input type="checkbox"/> Yes <input checked="" type="checkbox"/> No Weight 32 lbs./ft. 1 ___ in. to ___ ft. depth

2	Type and color of material	From	To
	top soil	0	165
	8ft loose gravel 7ft clay & porous rock	165	180
	15ft loose porous rock, little clay	180	195
	13ft gravel, 2ft rock	195	210
	4ft rock 11ft porous rock strip of clay	210	225
	12ft porous rock, little clay 3ft clay	225	240
	2ft fine sand 8ft clay little sand	240	255
	10ft fine sand 5ft porous rock little clay	255	270
	12ft fine sand 3ft clay	270	285
	15ft fine sand, loose	285	300
	315 325		
	5ft fine sand, 10ft clay & porous rock	300	315
	7ft clay, little sand 3ft shale	315	325
	(use a second sheet if needed)		

8 Screen: Manufacturer W.A. Brown Enterprises Type free flow Dia. 10" Slot gauge 3/16 Length 40' Set between 255 ft. and 325 ft. Fittings: 3/4" Gravel pack <input checked="" type="checkbox"/> Yes <input type="checkbox"/> No Size range of material ___
9 Static water level: 170 ft. below land surface Date 6-20-75
10 Pumping level below land surfaces: 300 ft. after 3 hrs. pumping 850 g.p.m. ___ ft. after ___ hrs. pumping ___ g.p.m. Estimated maximum yield 850 g.p.m.

11 Water sample submitted: <input type="checkbox"/> Yes <input checked="" type="checkbox"/> No Date ___
12 Well head completion: 12" <input type="checkbox"/> Pitless adapter <input checked="" type="checkbox"/> Inches above grade
13 Well grouted? <input checked="" type="checkbox"/> Yes <input type="checkbox"/> No Puddled <input type="checkbox"/> Neat cement <input type="checkbox"/> Bentonite <input type="checkbox"/> clay Depth: From 0 ft. to 10 ft.
14 Nearest source of possible contamination: ft. 0 Direction SE Type ___ Well disinfected upon completion? <input type="checkbox"/> Yes <input type="checkbox"/> No
15 Pump: <input type="checkbox"/> Not installed Manufacturer's name JMC Model number JMC HP ___ Volts ___ Length of drop pipe 310 ft. capacity 850 g.m.p. Type: <input type="checkbox"/> Submersible <input checked="" type="checkbox"/> Turbine <input type="checkbox"/> Jet <input type="checkbox"/> Reciprocating <input type="checkbox"/> Centrifugal <input type="checkbox"/> Other

16 Remarks: elevation 3835 (TOTO) Topography: <input type="checkbox"/> Hill <input type="checkbox"/> Slope <input checked="" type="checkbox"/> Upland <input type="checkbox"/> Valley irrigation well

17 Water well contractor's certification: This well was drilled under my jurisdiction and this report is true to the best of my knowledge and belief. Jack Poore Drilling Inc 197 Business name License No. ___ Address Goodland, Kans Signed Jack Poore Date 4-26-75 Authorized representative

7
14 SE NW NE
14 SE NW NE