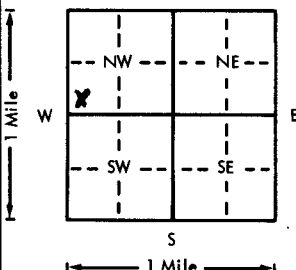
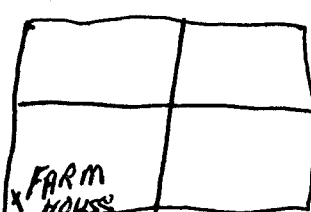


USE TYPEWRITER OR BALL  
POINT PEN-PRESS FIRMLY,  
PRINT CLEARLY.

WATER WELL RECORD  
KSA 82a-1201-1215

Kansas Department of Health and  
Environment-Division of Environment  
(Water well Contractors)  
Topeka, Kansas 66620

BCC

1. Location of well: County <u>SHEMAN</u>		Fraction <u>SW SW 1/4 NW 1/4</u>	Section number <u>29</u>	Township number <u>T 7 S</u>	Range number <u>R 42 E</u>
2. Distance and direction from nearest town or city: <u>6 N of KANORADO</u>			3. Owner of well: <u>STANLEY PETTIGONE</u> R.R. or street: City, state, zip code: <u>KANORADO, KANSAS 67741</u>		
4. Locate with "X" in section below: 		Sketch map: 			
5. Type and color of material			From	To	
<u>top soil and clay</u>			<u>0</u>	<u>201</u>	
<u>Gravel</u>			<u>201</u>	<u>205</u>	
<u>Clay</u>			<u>205</u>	<u>256</u>	
<u>Sand</u>			<u>256</u>	<u>258</u>	
<u>Sand &amp; clay</u>			<u>258</u>	<u>276</u>	
<u>Sandstone</u>			<u>276</u>	<u>282</u>	
<u>Sand &amp; sandstone</u>			<u>282</u>	<u>309</u>	
<u>Sandy clay</u>			<u>309</u>	<u>314</u>	
<u>Gravel</u>			<u>314</u>	<u>321</u>	
<u>soapstone</u>			<u>321</u>	<u>322</u>	
<u>Slate</u>			<u>322</u>	<u>323</u>	
<u>BROCK 321</u>					
<u>NEW well</u>					
<u>BARN</u>					
<u>HOUSE</u>					
<u>X CROSS POOL</u>					
18. Elevation:			19. Remarks:		
Topography: <input checked="" type="checkbox"/> Hill <input type="checkbox"/> Slope <input type="checkbox"/> Upland <input type="checkbox"/> Valley					
			20. Water well contractor's certification: This well was drilled under my jurisdiction and this report is true to the best of my knowledge and belief. <u>Forrest Supply Co. Inc.</u> Business name <u>Box 338</u> License No. <u>144</u> Address <u>Ralph Elmore</u> Signed <u>Ralph Elmore</u> Date <u>8-27-76</u> Authorized representative		