


1 LOCATION OF WATER WELL: County: <u>Sherman</u>	Fraction <u>NE 1/4 NE 1/4 SE 1/4</u>	Section Number <u>31</u>	Township Number T <u>7</u> S	Range Number R <u>42</u> E(W)
---	---	-----------------------------	---------------------------------	----------------------------------

Distance and direction from nearest town or city street address of well if located within city?

6 miles NE Kanorado

2 WATER WELL OWNER: Dale + Mary Vermillion  
 RR#, St. Address, Box #: 620 main  
 City, State, ZIP Code: Goodland, KS 67735  
 Board of Agriculture, Division of Water Resources  
 Application Number:

3 LOCATE WELL'S LOCATION WITH AN "X" IN SECTION BOX:

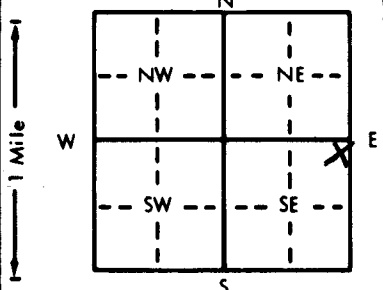

4 DEPTH OF COMPLETED WELL UNK ft. ELEVATION:

Depth(s) Groundwater Encountered 1. .ft. 2. .ft. 3. .ft.  
 WELL'S STATIC WATER LEVEL DRY ft. below land surface measured on mo/day/yr  
 Pump test data: Well water was .ft. after .hours pumping .gpm  
 Est. Yield .gpm: Well water was .ft. after .hours pumping .gpm  
 Bore Hole Diameter .in. to .ft., and .in. to .ft.  
 WELL WATER TO BE USED AS:  
 Domestic 3 Feedlot 6 Oil field water supply 9 Dewatering 12 Other (Specify below)  
 2 Irrigation 4 Industrial 7 Lawn and garden only 10 Monitoring well  
 Was a chemical/bacteriological sample submitted to Department? Yes.....No.....; If yes, mo/day/yr sample was submitted  
 Water Well Disinfected? Yes No

5 TYPE OF BLANK CASING USED:  
 Steel 3 RMP (SR) 5 Wrought iron 8 Concrete tile CASING JOINTS: Glued .Clamped .  
 2 PVC 4 ABS 7 Fiberglass . Welded .  
 Blank casing diameter .in. to .ft., Dia .in. to .ft., Dia .in. to .ft.  
 Casing height above land surface .in., weight .lbs./ft. Wall thickness or gauge No.

TYPE OF SCREEN OR PERFORATION MATERIAL:  
 1 Steel 3 Stainless steel 5 Fiberglass 7 PVC 10 Asbestos-cement  
 2 Brass 4 Galvanized steel 6 Concrete tile 8 RMP (SR) 11 Other (specify) .  
 SCREEN OR PERFORATION OPENINGS ARE:  
 1 Continuous slot 3 Mill slot 5 Gauzed wrapped 8 Saw cut 11 None (open hole)  
 2 Louvered shutter 4 Key punched 6 Wire wrapped 9 Drilled holes  
 7 Torch cut 10 Other (specify) .

SCREEN-PERFORATED INTERVALS: From .ft. to .ft., From .ft. to .ft., From .ft. to .ft.  
 GRAVEL PACK INTERVALS: From .ft. to .ft., From .ft. to .ft., From .ft. to .ft.

6 GROUT MATERIAL: 1 Neat cement 2 Cement grout 3 Bentonite 4 Other  
 Grout Intervals: From 3 ft. to 0 ft., From .ft. to .ft., From .ft. to .ft.

What is the nearest source of possible contamination:  
 1 Septic tank 4 Lateral lines 7 Pit privy 10 Livestock pens 14 Abandoned water well  
 2 Sewer lines 5 Cess pool 8 Sewage lagoon 11 Fuel storage 15 Oil well/Gas well  
 3 Watertight sewer lines 6 Seepage pit 9 Feedyard 12 Fertilizer storage 16 Other (specify below)  
 13 Insecticide storage .  
 Direction from well? How many feet?

FROM	TO	LITHOLOGIC LOG	FROM	TO	PLUGGING INTERVALS
<u>3</u>	<u>0</u>	<u>cement grout</u>			<u>WELL CASING FILLED WITH CLAY WITHIN 3' OF TOP, THE REMAINING 3' OF CASING CAPPED WITH CEMENT, WITH 6' OF DIRT COVERING THE CAP &amp; CASING.</u>

7 CONTRACTOR'S OR LANDOWNER'S CERTIFICATION: This water well was (1) constructed, (2) reconstructed, or (3) plugged under my jurisdiction and was completed on (mo/day/year) 10-21-1988 and this record is true to the best of my knowledge and belief. Kansas Water Well Contractor's License No. . This Water Well Record was completed on (mo/day/yr) 10-22-1988 under the business name of TENANT by (signature) Dale Vermillion

OFFICE USE ONLY  
T  
R  
EW  
SEC.