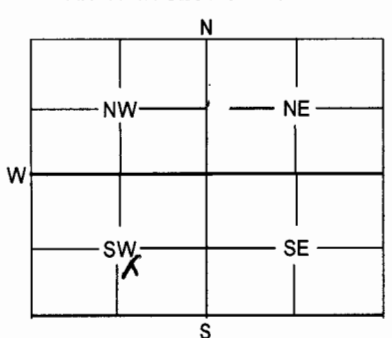


1	LOCATION OF WATER WELL:	Fraction	Section Number	Township Number	Range Number
	County: Mitchell	NW ^{1/4} SE ^{1/4} SW ^{1/4}	17	7	6

Distance and direction from nearest town or city street address of well if located within city?

On property of Solomon Valley Feeders


2	WATER WELL OWNER: Solomon Valley Feeders	Board of Agriculture, Division of Water Resources
	RR #, St. Address, Box #: 3575 Jazmine Trl.	Application Number:
	City, State, ZIP Code: Beloit, KS 67420	

3	MARK WELL'S LOCATION WITH AN "X" IN SECTION BOX:	4	DEPTH OF WELL 62.5 ft.
			WELL'S STATIC WATER LEVEL 43.02 ft.
			WELL WAS USED AS:
			1 Domestic 5 Public Water Supply 9 Dewatering 2 Irrigation 6 Oil Field Water Supply 10 Monitoring Well 3 Feedlot 7 Domestic (Lawn & Garden) 11 Injection Well 4 Industrial 8 Air Conditioning 12 Other
			Was a chemical / bacteriological sample submitted to Department? Yes No <input checked="" type="checkbox"/>
			if yes, mo/day/yr sample was submitted
			Water Well Disinfected: Yes No <input checked="" type="checkbox"/>

5	TYPE OF BLANK CASING USED:
	1 Steel 3 RMP (SR) 5 Wrought 7 Fiberglass 9 Other (Specify below) <input checked="" type="checkbox"/> PVC 4 ABS 6 Asbestos-Cement 8 Concrete Tile
	Blank casing diameter 5 in. Was casing pulled? Yes <input checked="" type="checkbox"/> No If yes, how much 40 ft
	Casing height above or below land surface 36 in.

6	GROUT PLUG MATERIAL: 1 Neat cement 2 Cement grout <input checked="" type="checkbox"/> Bentonite 4 Other
	Grout Plug Intervals: From 29 ft. to 0 ft., From ft. to ft., From to ft.
	What is the nearest source of possible contamination:
	1 Septic tank 6 Seepage pit 11 Fuel storage 16 Other (specify below) 2 Sewer lines 7 Pit privy 12 Fertilizer storage 3 Watertight sewer lines 8 Sewage lagoon 13 Insecticide storage 4 Lateral lines <input checked="" type="checkbox"/> Feedyard 14 Abandoned water well 5 Cess pool <input checked="" type="checkbox"/> Livestock pens 15 Oil well/Gas well
	Direction from well? IMMEDIATE VICINITY How many feet? IMMEDIATE VICINITY

FROM	TO	PLUGGING MATERIALS
0	29	Bentonite chips, hydrated
		MW -1

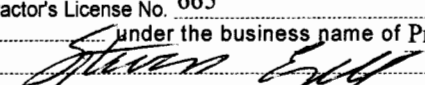7	CONTRACTOR'S OF LANDOWNER'S CERTIFICATION: This water well was plugged under my jurisdiction and was completed on (mo/day/year) 3/13/08 and this record is true to the best of my knowledge and belief. Kansas Water Well Contractor's License No. 665 This Water Well Record was completed on (mo/day/year) 5/2/08 under the business name of Pratt Well Service, Inc.
	by (signature) 

INSTRUCTIONS: Use typewriter or ball point pen. Please press firmly and print clearly. Please fill in blanks, underline or circle the correct answers. Send top three copies to Kansas Department of Health and Environment, Bureau of Water, Geology Section, 1 000 SW Jackson St., Ste. 420, Topeka, Kansas 66612-1367. Telephone: 785/296-5522. Send one to Water Well Owner and retain one for your records.