


1] LOCATION OF WATER WELL: Fraction SW 1/4 SW 1/4 NE 1/4 Section Number 9 Township Number T 7 S Range Number R 7 E/W
 County: Mitchell

Distance and direction from nearest town or city street address of well if located within city?
(Backyard) 301 S. Park, Beloit, Kansas 67420

2] WATER WELL OWNER: Earl Waterman
 RR#, St. Address, Box #: 301 S. Park
 City, State, ZIP Code: Beloit, Kansas 67420
 Board of Agriculture, Division of Water Resources
 Application Number:

3] LOCATE WELL'S LOCATION WITH AN "X" IN SECTION BOX:
 4] DEPTH OF COMPLETED WELL: 53 ft. ELEVATION: N/A

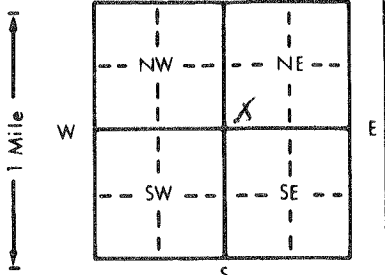

Depth(s) Groundwater Encountered 1. 40 ft. 2. ft. 3. ft.
 WELL'S STATIC WATER LEVEL . . . 39 . . . ft. below land surface measured on mo/day/yr . . . 6-21-96 . . .
N/A Pump test data: Well water was ft. after hours pumping gpm
 Est. Yield . . . 10 . . . gpm: Well water was ft. after hours pumping gpm
 Bore Hole Diameter . . . 9 . . . in. to . . . 53 . . . ft., and in. to ft.
 WELL WATER TO BE USED AS:
 5 Public water supply 8 Air conditioning 11 Injection well
 1 Domestic 3 Feedlot 6 Oil field water supply 9 Dewatering 12 Other (Specify below)
 2 Irrigation 4 Industrial 7 Lawn and garden only 10 Monitoring well
 Was a chemical/bacteriological sample submitted to Department? Yes No ; If yes, mo/day/yr sample was submitted
 Water Well Disinfected? Yes No

5] TYPE OF BLANK CASING USED:
 1 Steel 3 RMP (SR) 5 Wrought iron 8 Concrete tile CASING JOINTS: Glued Clamped
2 PVC 4 ABS 6 Asbestos-Cement 9 Other (specify below) Welded
 Blank casing diameter 5 . . . in. to . . . 33 . . . ft., Dia in. to ft., Dia in. to ft.
 Casing height above land surface 18 . . . in., weight lbs./ft. Wall thickness or gauge No. SDR 21

TYPE OF SCREEN OR PERFORATION MATERIAL:
 1 Steel 3 Stainless steel 5 Fiberglass 8 RMP (SR) 10 Asbestos-cement
 2 Brass 4 Galvanized steel 6 Concrete tile 9 ABS 12 None used (open hole)

SCREEN OR PERFORATION OPENINGS ARE:
 1 Continuous slot 3 Mill slot 5 Gauzed wrapped 8 Saw cut 11 None (open hole)
 2 Louvered shutter 4 Key punched 6 Wire wrapped 9 Drilled holes
 7 Torch cut 10 Other (specify)

SCREEN-PERFORATED INTERVALS: From 33 . . . ft. to . . . 53 . . . ft., From ft. to ft.
 From ft. to ft., From ft. to ft.
 GRAVEL PACK INTERVALS: From T.D. . . . 53 . . . ft. to . . . 30 . . . ft., From ft. to ft.
 From 25 . . . ft. to 20 . . . ft., From ft. to ft.

6] GROUT MATERIAL: 1 Neat cement 2 Cement grout 3 Bentonite 4 Other
 Grout Intervals: From 3 . . . 30 . . . ft. to . . . 25 . . . ft., From 1 . . . 20 . . . ft. to . . . surface . . . ft., From ft. to ft.

What is the nearest source of possible contamination:
 1 Septic tank 4 Lateral lines 7 Pit privy 10 Livestock pens 14 Abandoned water well
 2 Sewer lines 5 Cess pool 8 Sewage lagoon 11 Fuel storage 15 Oil well/Gas well
 3 Watertight sewer lines 6 Seepage pit 9 Feedyard 12 Fertilizer storage 16 Other (specify below)
 13 Insecticide storage
 Direction from well? North How many feet? 80

FROM	TO	LITHOLOGIC LOG	FROM	TO	PLUGGING INTERVALS
0	4	loess			
4	8	very silty clay			
8	13	yellow clay			
13	18	yellow & tan clay w/ intermitten sd lens and sparce, w/ wt. smooth lms r.k.			
18	22	yellow clay			
22	28	" " w/ v. f. gr. sd. lens			
28	35	same as above but sch. increasing			
35	40	v. f. gr. sd.			
40	45	med to lrg. gr. sand			
45	48	lrg. gr. sand and lrg. gravel			
49	51	weathered shale			
51	53	blue gray hard fissile shale			

7] CONTRACTOR'S OR LANDOWNER'S CERTIFICATION: This water well was (1) constructed, (2) reconstructed, or (3) plugged under my jurisdiction and was completed on (mo/day/year) 6-20-96 and this record is true to the best of my knowledge and belief. Kansas Water Well Contractor's License No. 608 This Water Well Record was completed on (mo/day/yr) 6-29-96 under the business name of Yellow Jacket Drilling by (signature) Earl Waterman

INSTRUCTIONS: Use typewriter or ball point pen. PLEASE PRESS FIRMLY and PRINT clearly. Please fill in blanks, underline or circle the correct answers. Send top three copies to Kansas Department of Health and Environment, Bureau of Water, Topeka, Kansas 66620-0001. Telephone: 913-296-5545. Send one to WATER WELL OWNER and retain one for your records.