


1 LOCATION OF WATER WELL: County: Mitchell Fraction: NE 1/4 SE 1/4 NE 1/4 Section Number: 7 Township Number: T 7 S Range Number: R 7 E

Distance and direction from nearest town or city street address of well if located within city?
3 miles East Jct 18 & 24 at Beloit, 1/4 mile south

2 WATER WELL OWNER: Charles File
 RR#, St. Address, Box #: R.R. #1
 City, State, ZIP Code: Beloit, Ks.
 Board of Agriculture, Division of Water Resources
 Application Number: Dry hole

3 LOCATE WELL'S LOCATION WITH AN "X" IN SECTION BOX:

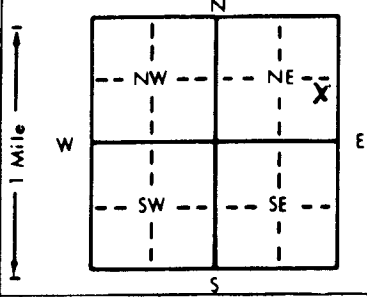

4 DEPTH OF COMPLETED WELL: 33' ft. ELEVATION: 24 ft.
 Depth(s) Groundwater Encountered 1. 31 ft. 2. 24 ft. 3. 10-4-96 ft.
 WELL'S STATIC WATER LEVEL 31 ft. below land surface measured on mo/day/yr 10-4-96
 Pump test data: Well water was 24 ft. after 2 hours pumping 7 gpm
 Est. Yield 1/2 gpm: Well water was 31 ft. after 2 hours pumping 7 gpm
 Bore Hole Diameter: 5 in. to 33' ft., and 33' in. to 33' ft.
 WELL WATER TO BE USED AS:
 1 Domestic Feedlot 6 Oil field water supply 9 Dewatering 12 Other (Specify below)
 2 Irrigation 4 Industrial 7 Lawn and garden only 10 Monitoring well
 Was a chemical/bacteriological sample submitted to Department? Yes No
 Water Well Disinfected? Yes No

5 TYPE OF BLANK CASING USED:
 1 Steel 3 RMP (SR) 5 Wrought iron 8 Concrete tile CASING JOINTS: Glued Clamped
 2 PVC 4 ABS 6 Asbestos-Cement 9 Other (specify below) Welded
 7 Fiberglass Threaded
 Blank casing diameter 5 in. to 33' ft., Dia 5 in. to 33' ft., Dia 5 in. to 33' ft.
 Casing height above land surface 5 in., weight 5 lbs./ft. Wall thickness or gauge No. 5
 TYPE OF SCREEN OR PERFORATION MATERIAL:
 1 Steel 3 Stainless steel 5 Fiberglass 7 PVC 10 Asbestos-cement
 2 Brass 4 Galvanized steel 6 Concrete tile 8 RMP (SR) 11 Other (specify) 10
 12 None used (open hole)
 SCREEN OR PERFORATION OPENINGS ARE:
 1 Continuous slot 3 Mill slot 5 Gauzed wrapped 8 Saw cut 11 None (open hole)
 2 Louvered shutter 4 Key punched 6 Wire wrapped 9 Drilled holes
 7 Torch cut 10 Other (specify) 10
 SCREEN-PERFORATED INTERVALS: From 0 ft. to 33 ft., From 0 ft. to 33 ft., From 0 ft. to 33 ft.
 GRAVEL PACK INTERVALS: From 0 ft. to 33 ft., From 0 ft. to 33 ft., From 0 ft. to 33 ft.

6 GROUT MATERIAL: 1 Neat cement 2 Cement grout Bentonite 4 Other 100' N.
 Grout intervals: From 20 ft. to 0 ft., From 0 ft. to 0 ft., From 0 ft. to 0 ft., From 0 ft. to 0 ft.
 What is the nearest source of possible contamination:
 1 Septic tank 4 Lateral lines 7 Pit privy Livestock pens 14 Abandoned water well
 2 Sewer lines 5 Cess pool 8 Sewage lagoon 11 Fuel storage 15 Oil well/Gas well
 3 Watertight sewer lines 6 Seepage pit 9 Feedyard 12 Fertilizer storage 16 Other (specify below)
 13 Insecticide storage
 Direction from well? How many feet?

FROM	TO	LITHOLOGIC LOG	FROM	TO	PLUGGING INTERVALS
0	15	1ms loess, clay	30	20	CMA gravel
15	16	1ms layer	20	0	Bentonite chip
16	24	1ms frag			
24	28	clay & weathered shale			
28	33	shale - bit blue gray			

7 CONTRACTOR'S OR LANDOWNER'S CERTIFICATION: This water well was (1) constructed, (2) reconstructed, or (3) plugged under my jurisdiction and was completed on (mo/day/year) 608 10-4-96 and this record is true to the best of my knowledge and belief. Kansas Water Well Contractor's License No. 608 This Water Well Record was completed on (mo/day/yr) 11-16-96 under the business name of Yellow Jacket Drilling by (signature) [Signature]