


1 LOCATION OF WATER WELL: County: Mitchell Fraction: NE 1/4 SW 1/4 SE 1/4 Section Number: 3 Township Number: T 7 S Range Number: R 7 E

Distance and direction from nearest town or city street address of well if located within city? 1 mile east of Beloit on RR #1

2 WATER WELL OWNER: Bill Fife RR#, St. Address, Box #: RR #1 Dry hole City, State, ZIP Code: Beloit, KS 67420 Board of Agriculture, Division of Water Resources Application Number:

3 LOCATE WELL'S LOCATION WITH AN "X" IN SECTION BOX:

4 DEPTH OF COMPLETED WELL: 33 ft. ELEVATION:

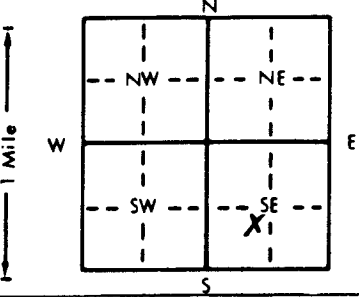

Depth(s) Groundwater Encountered 1. None ft. 2. None ft. 3. None ft.
 WELL'S STATIC WATER LEVEL 0/NA/999 ft. below land surface measured on mo/day/yr
 Pump test data: Well water was NA ft. after NA hours pumping NA gpm
 Est. Yield 0 gpm: Well water was NA ft. after NA hours pumping NA gpm
 Bore Hole Diameter: 9 in. to 33 ft., and NA in. to NA ft.
 WELL WATER TO BE USED AS: 5 Public water supply 8 Air conditioning 11 Injection well
 1 Domestic 3 Feedlot 6 Oil field water supply 9 Dewatering 12 Other (Specify below)
 2 Irrigation 4 Industrial 7 Lawn and garden only 10 Monitoring well
 Was a chemical/bacteriological sample submitted to Department? Yes NO; If yes, mo/day/yr sample was submitted
 Water Well Disinfected? Yes No

5 TYPE OF BLANK CASING USED: 1 Steel 3 RMP (SR) 5 Wrought iron 8 Concrete tile CASING JOINTS: Glued Clamped
 2 PVC 4 ABS 6 Asbestos-Cement 9 Other (specify below) Welded
 7 Fiberglass NONE Threaded
 Blank casing diameter Ø in. to Ø ft., Dia Ø in. to Ø ft., Dia Ø in. to Ø ft.
 Casing height above land surface Ø in., weight Ø lbs./ft. Wall thickness or gauge No. Ø

TYPE OF SCREEN OR PERFORATION MATERIAL: 1 Steel 3 Stainless steel 5 Fiberglass 8 RMP (SR) 10 Asbestos-cement
 2 Brass 4 Galvanized steel 6 Concrete tile 9 ABS 11 Other (specify) NA
 12 None used (open hole)

SCREEN OR PERFORATION OPENINGS ARE: 5 Gauzed wrapped 8 Saw cut 11 None (open hole)
 1 Continuous slot 3 Mill slot 6 Wire wrapped 9 Drilled holes NA
 2 Louvered shutter 4 Key punched 7 Torch cut 10 Other (specify) NA

SCREEN-PERFORATED INTERVALS: From 999 ft. to 999 ft., From Ø ft. to Ø ft.
 From Ø ft. to Ø ft., From Ø ft. to Ø ft.
 GRAVEL PACK INTERVALS: From 33 ft. to 20 ft., From Ø ft. to Ø ft.
 From Ø ft. to Ø ft., From Ø ft. to Ø ft.

6 GROUT MATERIAL: 1 Neat cement 2 Cement grout 3 Bentonite 4 Other
 Grout Intervals: From 20 ft. to 0 ft., From Ø ft. to Ø ft., From Ø ft. to Ø ft.
 What is the nearest source of possible contamination: 10 Livestock pens 14 Abandoned water well
 1 Septic tank 4 Lateral lines Ø Pit privy 11 Fuel storage 15 Oil well/Gas well
 2 Sewer lines 5 Cess pool 8 Sewage lagoon 12 Fertilizer storage 16 Other (specify below)
 3 Watertight sewer lines 6 Seepage pit 9 Feedyard 13 Insecticide storage

Direction from well? 100' west How many feet?

FROM	TO	LITHOLOGIC LOG	FROM	TO	PLUGGING INTERVALS
0	5	loess	33	20	CMA Gravel
5	9	dk clay	20	0	Medium Bentonite Chip
9	13	white clay			
13	33	shale			

7 CONTRACTOR'S OR LANDOWNER'S CERTIFICATION: This water well was (1) constructed, (2) reconstructed, or (3) plugged under my jurisdiction and was completed on (mo/day/year) 10-10-96 and this record is true to the best of my knowledge and belief. Kansas Water Well Contractor's License No. 608 This Water Well Record was completed on (mo/day/yr) 11-16-96 under the business name of Yellow Jacket by (signature) E. J. Woodell

OFFICE USE ONLY
T
R
EW
SEC.
1/4
1/4
1/4