


1 LOCATION OF WATER WELL: County: Michell Fraction: C 1/4 NW 1/4 SW 1/4 Section Number: 3 Township Number: T 7 S Range Number: R 7 EW

Distance and direction from nearest town or city street address of well if located within city?
1 mile east of Beloit on golf course rd

2 WATER WELL OWNER: Bill File RR#, St. Address, Box #: Beloit, KS 67420 City, State, ZIP Code: Beloit, KS 67420 Board of Agriculture, Division of Water Resources Application Number: Dry hole

3 LOCATE WELL'S LOCATION WITH AN "X" IN SECTION BOX:

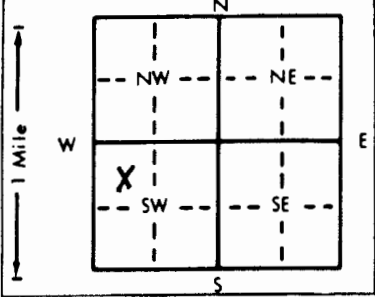

4 DEPTH OF COMPLETED WELL: 33 ft. ELEVATION: _____ ft.
 Depth(s) Groundwater Encountered: 1. NONE ft. 2. _____ ft. 3. _____ ft.
 WELL'S STATIC WATER LEVEL: NA ft. below land surface measured on mo/day/yr
 Pump test data: Well water was _____ ft. after _____ hours pumping _____ gpm
 Est. Yield: 0 gpm; Well water was _____ ft. after _____ hours pumping _____ gpm
 Bore Hole Diameter: 3.9 in. to 33 ft., and _____ in. to _____ ft.
 WELL WATER TO BE USED AS:
 1 Domestic 3 Feedlot 6 Oil field water supply 9 Dewatering 12 Other (Specify below) _____
 2 Irrigation 4 Industrial 7 Lawn and garden only 10 Monitoring well
 Was a chemical/bacteriological sample submitted to Department? Yes No If yes, mo/day/yr sample was submitted _____
 Water Well Disinfected? Yes No

5 TYPE OF CASING USED:
 1 Steel 3 RMP (SR) 5 Wrought iron 8 Concrete tile CASING JOINTS: Glued _____ Clamped _____
 2 PVC 4 ABS 6 Asbestos-Cement 9 Other (specify below) NONE Welded _____
 7 Fiberglass _____ Threaded _____
 Blank casing diameter: 0 in. to _____ ft., Dia. _____ in. to _____ ft., Dia. _____ in. to _____ ft.
 Casing height above land surface: 0 in., weight _____ lbs./ft. Wall thickness or gauge No. _____

TYPE OF SCREEN OR PERFORATION MATERIAL:
 1 Steel 3 Stainless steel 5 Fiberglass 7 PVC 10 Asbestos-cement
 2 Brass 4 Galvanized steel 6 Concrete tile 8 RMP (SR) 11 Other (specify) NA
 9 ABS 12 None used (open hole)

SCREEN OR PERFORATION OPENINGS ARE:
 1 Continuous slot 3 Mill slot 5 Gauzed wrapped 8 Saw cut 11 None (open hole)
 2 Louvered shutter 4 Key punched 6 Wire wrapped 9 Drilled holes
 7 Torch cut 10 Other (specify) NA

SCREEN-PERFORATED INTERVALS: From 999 ft. to 999 ft., From _____ ft. to _____ ft.
 From _____ ft. to _____ ft., From _____ ft. to _____ ft.
 GRAVEL PACK INTERVALS: From 33 ft. to 20 ft., From _____ ft. to _____ ft.
 From _____ ft. to _____ ft., From _____ ft. to _____ ft.

6 GROUT MATERIAL: 1 Neat cement 2 Cement grout 3 Bentonite 4 Other _____
 Grout Intervals: From 20 ft. to 0 ft., From _____ ft. to _____ ft., From _____ ft. to _____ ft.

What is the nearest source of possible contamination:
 1 Septic tank 4 Lateral lines 7 Pit privy 10 Livestock pens 14 Abandoned water well
 2 Sewer lines 5 Cess pool 8 Sewage lagoon 11 Fuel storage 15 Oil well/Gas well
 3 Watertight sewer lines 6 Seepage pit 9 Feedyard 12 Fertilizer storage 16 Other (specify below) Grain Bins
 13 Insecticide storage How many feet? 100' S.

Direction from well?		LITHOLOGIC LOG		PLUGGING INTERVALS	
FROM	TO	FROM	TO	FROM	TO
0	4	loess	33	20	CMA Gravel
5	8	clay	20	0	Medium bentonite chip
9	28	soft - dry no water			
28	30	chert - spottay			
30	33	weathered and hard shale			

7 CONTRACTOR'S OR LANDOWNER'S CERTIFICATION: This water well was (1) constructed, (2) reconstructed, or (3) plugged under my jurisdiction and was completed on (mo/day/year) 10-10-96 and this record is true to the best of my knowledge and belief. Kansas Water Well Contractor's License No. 608 This Water Well Record was completed on (mo/day/yr) 11-16-96 under the business name of Yellow Jacket Drilling by (signature) [Signature]