


1 LOCATION OF WATER WELL: Fraction **SE 1/4 NE 1/4 NE 1/4** Section Number **8** Township Number **T 7 S** Range Number **R 7 W**
 County: **Mitchell**

Distance and direction from nearest town or city street address of well if located within city?

City limits - 619 N. Central, Beloit, Ks

2 WATER WELL OWNER: **Jeff Roberg**
 RR#, St. Address, Box # : **619 N. Central** Board of Agriculture, Division of Water Resources
 City, State, ZIP Code : **Beloit, Ks. 67420** Application Number:

3 LOCATE WELL'S LOCATION WITH AN "X" IN SECTION BOX: 4 DEPTH OF COMPLETED WELL **58** ft. ELEVATION:

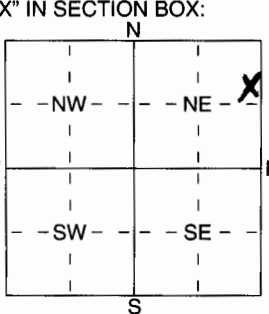

Depth(s) Groundwater Encountered 1 ft. 2 ft. 3 ft.
 WELL'S STATIC WATER LEVEL **32** ft. below land surface measured on mo/day/yr
 Pump test data: Well water was ft. after hours pumping gpm
 Est. Yield **3-5** gpm: Well water was ft. after hours pumping gpm
 WELL WATER TO BE USED AS: 5 Public water supply 8 Air conditioning 11 Injection well
 1 Domestic 3 Feedlot 6 Oil field water supply 9 Dewatering 12 Other (Specify below)
 2 Irrigation 4 Industrial **X** Domestic (lawn & garden) 10 Monitoring well

Was a chemical/bacteriological sample submitted to Department? Yes No **X** ; If yes, mo/day/yr sample was submitted
 Water Well Disinfected? Yes **X** No

5 TYPE OF BLANK CASING USED: 5 Wrought iron 8 Concrete tile CASING JOINTS: Glued **X** Clamped
 1 Steel 3 RMP (SR) 6 Asbestos-Cement 9 Other (specify below) Welded
X PVC 4 ABS 7 Fiberglass Threaded

Blank casing diameter **5** in. to **38** ft., Dia in. to ft., Dia in. to ft.
 Casing height above land surface **12** in., weight **2.37** lbs./ft. Wall thickness or gauge No. **0.214**

TYPE OF SCREEN OR PERFORATION MATERIAL: **X** PVC 10 Asbestos-Cement
 1 Steel 3 Stainless Steel 5 Fiberglass 8 RMP (SR) 11 Other (Specify)
 2 Brass 4 Galvanized Steel 6 Concrete tile 9 ABS 12 None used (open hole)

SCREEN OR PERFORATION OPENINGS ARE: 5 Gauzed wrapped 8 Saw cut 11 None (open hole)
 1 Continuous slot **X** Mill slot 6 Wire wrapped 9 Drilled holes
 2 Louvered shutter 4 Key punched 7 Torch cut 10 Other (specify)

SCREEN-PERFORATED INTERVALS: From **38** ft. to **58** ft., From ft. to ft.
 GRAVEL PACK INTERVALS: From **22** ft. to **58** ft., From ft. to ft.

6 GROUT MATERIAL: 1 Neat cement 2 Cement grout **X** Bentonite 4 Other

Grout Intervals: From **0** ft. to **22** ft., From ft. to ft., From ft. to ft.

What is the nearest source of possible contamination: ~~none within 1/4 mile~~ 10 Livestock pens 14 Abandoned water well
 1 Septic tank 4 Lateral lines 7 Pit privy 11 Fuel storage 15 Oil well/Gas well
 2 Sewer lines 5 Cess pool 8 Sewage lagoon 12 Fertilizer storage 16 Other (specify below)
3 Watertight sewer lines 6 Seepage pit 9 Feedyard 13 Insecticide storage
 Direction from well? **EAST** How many feet? **100'**

| FROM | TO | LITHOLOGIC LOG | FROM | TO | PLUGGING INTERVALS |
|------|----|----------------------|------|----|--------------------|
| 0 | 2 | Topsoil | | | |
| 2 | 5 | Clay, tan | | | |
| 5 | 10 | Clay, tan/sandy | | | |
| 10 | 15 | Sand, fine to medium | | | |
| 15 | 16 | Clay, gray | | | |
| 16 | 38 | Sand, fine | | | |
| 38 | 58 | Shale, gray | | | |

7 CONTRACTOR'S OR LANDOWNER'S CERTIFICATION: This water well was (1) constructed, (2) reconstructed, or (3) plugged under my jurisdiction and was completed on (mo/day/year) **7/7/04** and this record is true to the best of my knowledge and belief. Kansas Water Well Contractor's Licence No **138** This Water Well Record was completed on (mo/day/yr) **7/16/04** under the business name of **Peterson Irrigation, Inc.** by (signature) **Mike Peterson**