


1 LOCATION OF WATER WELL: County: MITCHELL Fraction NE 1/4 SE 1/4 NE 1/4 Section Number 9 Township Number T 7 S Range Number R 7 EW

2 WATER WELL OWNER: MICHAEL PESTINGER RR#, St. Address, Box #: 214 N. POPLAR City, State, ZIP Code: BELOTT, KS. 67420 Board of Agriculture, Division of Water Resources Application Number:

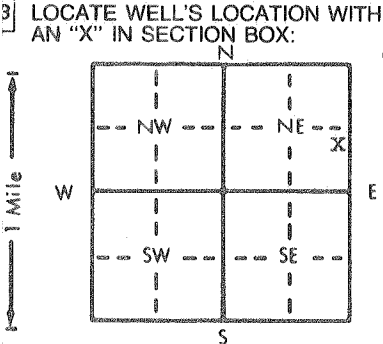

3 LOCATE WELL'S LOCATION WITH AN 'X' IN SECTION BOX: 4 DEPTH OF COMPLETED WELL: 61.5 ft. ELEVATION: 1250 WELL'S STATIC WATER LEVEL: 41 ft. below land surface measured on mo/day/yr 4-8-90 Pump test data: Well water was 45 ft. after 2 hours pumping 20 gpm Est. Yield: 50+ gpm: Well water was ft. after hours pumping gpm Bore Hole Diameter: 9 in. to 62 ft. and in. to ft. WELL WATER TO BE USED AS: 5 Public water supply 8 Air conditioning 11 Injection well 1 Domestic 3 Feedlot 6 Oil field water supply 9 Dewatering 12 Other (Specify below) 2 Irrigation 4 Industrial 7 Lawn and garden only 10 Monitoring well Was a chemical/bacteriological sample submitted to Department? Yes No X; If yes, mo/day/yr sample was submitted Water Well Disinfected? Yes X No

5 TYPE OF BLANK CASING USED: 1 Steel 3 RMP (SR) 5 Wrought iron 8 Concrete tile CASING JOINTS: Glued X Clamped 2 PVC 4 ABS 6 Asbestos-Cement 9 Other (specify below) Welded 7 Fiberglass Threaded Blank casing diameter: 5 in. to 41.5 ft., Dia. in. to ft., Dia. in. to ft. Casing height above land surface: 30 in., weight 160 lbs./ft. Wall thickness or gauge No. SDR 26

TYPE OF SCREEN OR PERFORATION MATERIAL: 1 Steel 3 Stainless steel 5 Fiberglass 8 RMP (SR) 10 Asbestos-cement 2 Brass 4 Galvanized steel 6 Concrete tile 9 ABS 11 Other (specify) 12 None used (open hole)

SCREEN OR PERFORATION OPENINGS ARE: 1 Continuous slot 3 Mill slot .035 5 Gauzed wrapped 8 Saw cut 11 None (open hole) 2 Louvered shutter 4 Key punched 6 Wire wrapped 9 Drilled holes 10 Other (specify) SCREEN-PERFORATED INTERVALS: From 41.5 ft. to 61.5 ft. GRAVEL PACK INTERVALS: From 25 ft. to 61.5 ft.

6 GROUT MATERIAL: 1 Neat cement 2 Cement grout 3 Bentonite 4 Other Grout Intervals: From 0 ft. to 25 ft., From ft. to ft., From ft. to ft. What is the nearest source of possible contamination: 1 Septic tank 4 Lateral lines 7 Pit privy 10 Livestock pens 14 Abandoned water well 2 Sewer lines 5 Cess pool 8 Sewage lagoon 11 Fuel storage 15 Oil well/Gas well 3 Watertight sewer lines 6 Seepage pit 9 Feedyard 12 Fertilizer storage 16 Other (specify below) 13 Insecticide storage Direction from well? NORTH How many feet? 20

Table with columns: FROM, TO, LITHOLOGIC LOG, FROM, TO, PLUGGING INTERVALS. Rows include: 0-3 TOP SOIL, 3-41 SANDY LOOM & CLAY LAYERS, 41-50 SAND, 50-61.5 SMALL GRAVEL & SAND.

7 CONTRACTOR'S OR LANDOWNER'S CERTIFICATION: This water well was (1) constructed, (2) reconstructed, or (3) plugged under my jurisdiction and was completed on (mo/day/year) 4-8-90 and this record is true to the best of my knowledge and belief. Kansas Water Well Contractor's License No. 388 This Water Well Record was completed on (mo/day/yr) 4-8-90 under the business name of PESTINGER PUMP SERVICE by (signature) Michael Pestinger