


LOCATION OF WATER WELL: Fraction NE 1/4 NW 1/4 SW 1/4 Section Number 10 Township Number T 7 S Range Number R 7 E(W)  
 County: Mitchell

Distance and direction from nearest town or city street address of well if located within city?  
1208 Ash Beloit Kansas

WATER WELL OWNER: Larry Meir  
 RR#, St. Address, Box #: 1208 Ash  
 City, State, ZIP Code: Beloit Kansas  
 Board of Agriculture, Division of Water Resources  
 Application Number:

LOCATE WELL'S LOCATION WITH AN "X" IN SECTION BOX:

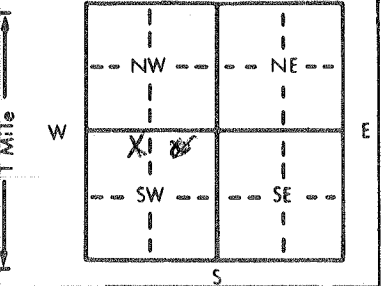

DEPTH OF COMPLETED WELL: 5.3 ft. ELEVATION:  
 Depth(s) Groundwater Encountered 1. 4.4 ft. 2. ft. 3. ft.  
 WELL'S STATIC WATER LEVEL: 4.4 ft. below land surface measured on mo/day/yr 5/20/89  
 Pump test data: Well water was 4.4 ft. after 24 hours pumping 15 gpm  
 Est. Yield gpm: Well water was 15 ft. after hours pumping gpm  
 Bore Hole Diameter: 9 in. to 3.5 ft., and in. to ft.  
 WELL WATER TO BE USED AS:  
 5 Public water supply 8 Air conditioning 11 Injection well  
 1 Domestic 3 Feedlot 6 Oil field water supply 9 Dewatering 12 Other (Specify below)  
 2 Irrigation 4 Industrial 7 Lawn and garden only 10 Monitoring well  
 Was a chemical/bacteriological sample submitted to Department? Yes.....No. X.....; If yes, mo/day/yr sample was submitted  
 Water Well Disinfected? Yes No X

TYPE OF BLANK CASING USED:  
 1 Steel 2 PVC 3 RMP (SR) 4 ABS 5 Wrought iron 6 Asbestos-Cement 7 Fiberglass 8 Concrete tile 9 Other (specify below) 10 Asbestos-cement  
 Blank casing diameter 5 in. to 5.3 ft., Dia. in. to ft., Dia. in. to ft.  
 Casing height above land surface 14 in., weight lbs./ft. Wall thickness or gauge No. 50 40

TYPE OF SCREEN OR PERFORATION MATERIAL:  
 1 Steel 2 Brass 3 Stainless steel 4 Galvanized steel 5 Fiberglass 6 Concrete tile 7 PVC 8 RMP (SR) 9 ABS 10 Asbestos-cement 11 Other (specify) 12 None used (open hole)

SCREEN OR PERFORATION OPENINGS ARE:  
 1 Continuous slot 2 Louvered shutter 3 Mill slot 4 Key punched 5 Gauzed wrapped 6 Wire wrapped 7 Torch cut 8 Saw cut 9 Drilled holes 10 Other (specify) 11 None (open hole)

SCREEN-PERFORATED INTERVALS: From 4.3 ft. to 5.3 ft., From ft. to ft.  
 GRAVEL PACK INTERVALS: From ft. to ft., From ft. to ft.

GROUT MATERIAL: 1 Neat cement 2 Cement grout 3 Bentonite 4 Other  
 Grout Intervals: From 0 ft. to 30 ft., From ft. to ft., From ft. to ft.

What is the nearest source of possible contamination:  
 1 Septic tank 2 Sewer lines 3 Watertight sewer lines 4 Lateral lines 5 Cess pool 6 Seepage pit 7 Pit privy 8 Sewage lagoon 9 Feedyard 10 Livestock pens 11 Fuel storage 12 Fertilizer storage 13 Insecticide storage 14 Abandoned water well 15 Oil well/Gas well 16 Other (specify below)

Direction from well? South How many feet? 40 ft

FROM	TO	LITHOLOGIC LOG	FROM	TO	PLUGGING INTERVALS
0	5	Topsail	0'	30	Cement Grout
5	20	Clay			
20	53	Sand			
53		SLATE	30	53	Gravel packed

CONTRACTOR'S OR LANDOWNER'S CERTIFICATION: This water well was (1) constructed, (2) reconstructed, or (3) plugged under my jurisdiction and was completed on (mo/day/year) 5/20/89 and this record is true to the best of my knowledge and belief. Kansas Water Well Contractor's License No. 511 This Water Well Record was completed on (mo/day/yr) 5-20-89 under the business name of B-S- Well Drilling by (signature) [Signature]