


WATER WELL RECORD Form WWC-5 KSA 82a-1212

1 LOCATION OF WATER WELL: County: Mitchell Fraction SW 1/4 SE 1/4 SW 1/4 Section Number 4 Township Number T 7 S Range Number R 7 EW

Distance and direction from nearest town or city street address of well if located within city? 100 W. 8th, Beloit, Kansas

2 WATER WELL OWNER: Mid West Petroleum RR#, St. Address, Box #: 9237 Ward Parkway Suite 100 City, State, ZIP Code: Kansas City, Mo 64114 Board of Agriculture, Division of Water Resources Application Number:

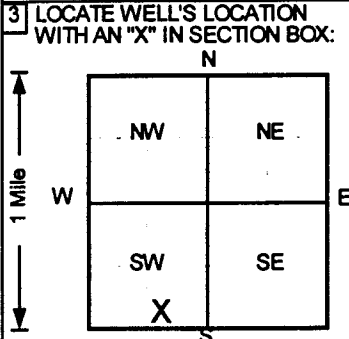

4 DEPTH OF COMPLETED WELL: 13 ft ELEVATION: 1435.6 ft. WELL'S STATIC WATER LEVEL: 4.88 ft below land surface measured on mo/day/yr 12/31/97. Pump test data: Well water was NA ft after hours pumping gpm. Est Yield NA gpm. Bore Hole Diameter 8 in. to 13 ft. WELL WATER TO BE USED AS: 10 Monitoring well. Was a chemical/bacteriological sample submitted to Department? No. If yes, mo/day/yr sample was submitted? No.

5 TYPE OF BLANK CASING USED: 2 PVC. 5 Wrought iron, 8 Concrete tile, CASING JOINTS: Glued, Clamped. Welded, Threaded. Blank casing diameter 2 in. to 3 ft, Dia. Casing height above land surface -5.4 in., weight Sch 40, lbs./ft. Wall thickness or gauge No.

TYPE OF SCREEN OR PERFORATION MATERIAL: 7 PVC. 1 Steel, 3 Stainless steel, 5 Fiberglass, 8 RMP (SR), 10 Asbestos-cement. 2 Brass, 4 Galvanized steel, 6 Concrete tile, 9 ABS, 12 None used (open hole).

SCREEN OR PERFORATION OPENINGS ARE: 3 Mill slot. 1 Continuous slot, 2 Louvered shutter, 4 Key punched, 5 Gauzed wrapped, 8 Saw cut, 11 None (open hole). 6 Wire wrapped, 9 Drilled holes, 7 Torch cut, 10 Other (specify).

SCREEN-PERFORATED INTERVALS: From 3 ft to 13 ft. GRAVEL PACK INTERVALS: From 2 ft to 13 ft.

6 GROUT MATERIAL: 2 Cement grout. Grout intervals: From 0 ft to 2 ft.

What is the nearest source of possible contamination: 16 Other (specify below) Former Tank Basin. 1 Septic tank, 4 Lateral lines, 7 Pit privy, 11 Fuel storage, 14 Abandoned water well. 2 Sewer lines, 5 Cess pool, 8 Sewage lagoon, 12 Fertilizer storage, 15 Oil well/Gas well. 3 Watertight sewer lines, 6 Seepage pit, 9 Feedyard, 13 Insecticide storage.

Table with columns: FROM, TO, LITHOLOGIC LOG, FROM, TO, PLUGGING INTERVALS. Rows show lithology: Sandy, Brown (0-8 ft), Sand, Gray (8-12 ft), Clay, brown (12-13 ft). Includes MW1, Tag # 00188900, Flushmount, Project Name: Beloit Self Service, GeoCore # 532, KDHE # U5 062 10121.

7 CONTRACTOR'S OR LANDOWNER'S CERTIFICATION: This water well was (1) constructed, (2) reconstructed, or (3) plugged under my jurisdiction and was completed on (mo/day/year) 12/15/97 and this record is true to the best of my knowledge and belief. Kansas Water Well Contractor's License No. 527. This Water Well Record was completed on (mo/day/yr) 1/20/98 under the business name of GeoCore Services, Inc. by (signature) Dan Kell.

INSTRUCTIONS: Use typewriter or ball point pen. PLEASE PRESS FIRMLY and PRINT clearly. Please fill in blanks, underline or circle the correct answers. Send top three copies to Kansas Department of Health and Environment, Bureau of Water, Topeka, Kansas 66620-0001. Telephone: 913-298-5545. Send one to WATER WELL OWNER and retain one for your records.