


1 LOCATION OF WATER WELL: Fraction SW 1/4 SE 1/4 SW 1/4 Section Number 4 Township Number T 7 S Range Number R 7 E **W**

Distance and direction from nearest town or city street address of well if located within city?
 100 W. 8th, Beloit, Kansas

2 WATER WELL OWNER: Mid West Petroleum
 RR#, St. Address, Box # : 9237 Ward Parkway Suite 100 Board of Agriculture, Division of Water Resources
 City, State, ZIP Code : Kansas City, Mo 64114 Application Number:

3 LOCATE WELL'S LOCATION WITH AN "X" IN SECTION BOX:

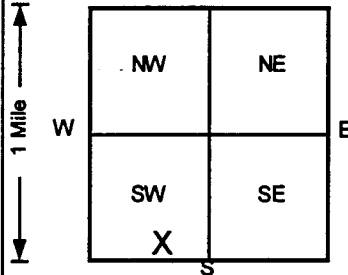

4 DEPTH OF COMPLETED WELL 20 ft ELEVATION 1437.78
 Depth(s) Groundwater Encountered 1. ft 2. ft 3. ft
 WELL'S STATIC WATER LEVEL . . . 9.13 ft below land surface measured on mo/day/yr . . . 12/31/97
 Pump test data: Well water was . . . NA ft after hours pumping gpm
 Est. Yield . . NA gpm: Well water was ft after hours pumping gpm
 Bore Hole Diameter . . . 8 in. to . . . 20 ft, and in. to ft
 WELL WATER TO BE USED AS: 5 Public water supply 8 Air conditioning 11 Injection well
 1 Domestic 3 Feedlot 6 Oil field water supply 9 Dewatering 12 Other (Specify below)
 2 Irrigation 4 Industrial 7 Lawn and garden only **10** Monitoring well
 Was a chemical/bacteriological sample submitted to Department Yes.....No ; If yes, mo/day/yr sample was submitted
 Water Well Disinfected? Yes No

5 TYPE OF BLANK CASING USED: 5 Wrought iron 8 Concrete tile CASING JOINTS: Glued Clamped
 1 Steel 3 RMP (SR) 6 Asbestos-Cement 9 Other (specify below) Welded
2 PVC 4 ABS 7 Fiberglass Threaded.

Blank casing diameter 2 in. to 10 ft, Dia in. to ft, Dia in. to ft
 Casing height above land surface -4.68 in., weight Sch 40 lbs./ft. Wall thickness or gauge No.

TYPE OF SCREEN OR PERFORATION MATERIAL **7** PVC 10 Asbestos-cement
 1 Steel 3 Stainless steel 5 Fiberglass 8 RMP (SR) 11 Other (specify)
 2 Brass 4 Galvanized steel 6 Concrete tile 9 ABS 12 None used (open hole)

SCREEN OR PERFORATION OPENINGS ARE:
 1 Continuous slot **3** Mill slot 5 Gauzed wrapped 8 Saw cut 11 None (open hole)
 2 Louvered shutter 4 Key punched 6 Wire wrapped 9 Drilled holes
 7 Torch cut 10 Other (specify)

SCREEN-PERFORATED INTERVALS: From 10 ft to 20 ft, From ft to ft
 From ft to ft, From ft to ft
 GRAVEL PACK INTERVALS: From 8 ft to 20 ft, From ft to ft
 From ft to ft, From ft to ft

6 GROUT MATERIAL: 1 Neat cement **2** Cement grout **3** Bentonite 4 Other
 Grout Intervals: From 0 ft to 6 ft, From 6 ft to 8 ft, From ft to ft

What is the nearest source of possible contamination:
 1 Septic tank 4 Lateral lines 7 Pit privy 10 Livestock pens 14 Abandoned water well
 2 Sewer lines 5 Cess pool 8 Sewage lagoon 11 Fuel storage 15 Oil well/Gas well
 3 Watertight sewer lines 6 Seepage pit 9 Feedyard 12 Fertilizer storage **16** Other (specify below)
 Former Tank Basin
 Direction from well? South How many feet? 25

FROM	TO	LITHOLOGIC LOG	FROM	TO	PLUGGING INTERVALS
0	2	Clay, Dark Brown			
2	3	Clay, Gray			
3	3.5	Limestone, Light Brown			
3.5	7	Sand, Light Brown			
7	7.5	Limestone, Light Brown-Yellow			
7.5	13	Clay, Gray-Yello			
13	20	Shale, Dark Gray			
					MW2, Tag # 00188917, Flushmount
					Project Name: Beloit Self Service
					GeoCore # 532, KDHE # U5 062 10121

7 CONTRACTOR'S OR LANDOWNER'S CERTIFICATION: This water well was **1** constructed, **2** reconstructed, or **3** plugged under my jurisdiction and was completed on (mo/day/year) 12/15/97 and this record is true to the best of my knowledge and belief.
 Kansas Water Well Contractor's License No. 527 This Water Well Record was completed on (mo/day/yr) 1/20/98 under the business name of GeoCore Services, Inc. by (signature) *Dak Bell*

INSTRUCTIONS: Use typewriter or ball point pen. PLEASE PRESS FIRMLY and PRINT clearly. Please fill in blanks, underline or circle the correct answers. Send top three copies to Kansas Department of Health and Environment, Bureau of Water, Topeka, Kansas 66620-0001. Telephone: 913-298-5545. Send one to WATER WELL OWNER and retain one for your records.

OFFICE USE ONLY
T
R
EM
SEC.
1/4
1/4
1/4