


1] LOCATION OF WATER WELL: County: Mitchell Fraction: SW 1/4 NE 1/4 NE 1/4 Section Number: 9 Township Number: T 7 S Range Number: R 7 AW

Distance and direction from nearest town or city street address of well if located within city?
109 S. Elm Beloit, Ks

2] WATER WELL OWNER: Richard Budke
 RR#, St. Address, Box #: 109 S. Elm
 City, State, ZIP Code: Beloit, Ks 67420
 Board of Agriculture, Division of Water Resources
 Application Number:

3] LOCATE WELL'S LOCATION WITH AN "X" IN SECTION BOX: 4] DEPTH OF COMPLETED WELL: 40' ft. ELEVATION: N/A

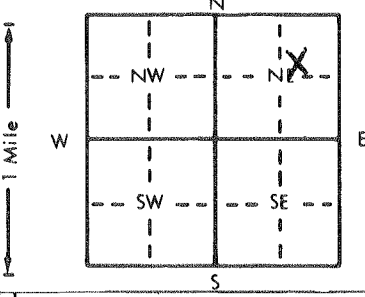

Depth(s) Groundwater Encountered 1. 27 ft. 2. 29 ft. 3. N/A ft.
 WELL'S STATIC WATER LEVEL 27 ft. below land surface measured on 8-1-97 mo/day/yr
 Pump test data: Well water was 29 ft. after 1 hours pumping 15 gpm
 Est. Yield 25+ gpm: Well water was 29 ft. after 1 hours pumping 15 gpm
 Bore Hole Diameter: 10 in. to 7.0 ft., and 7.0 in. to 7.0 ft.
 WELL WATER TO BE USED AS:
 5 Public water supply 8 Air conditioning 11 Injection well
 1 Domestic 3 Feedlot 6 Oil field water supply 9 Dewatering 12 Other (Specify below)
 2 Irrigation 4 Industrial 7 Lawn and garden only 10 Monitoring well
 Was a chemical/bacteriological sample submitted to Department? Yes No; If yes, mo/day/yr sample was submitted
 Water Well Disinfected? Yes No

5] TYPE OF BLANK CASING USED:
 1 Steel 3 RMP (SR) 5 Wrought iron 8 Concrete tile CASING JOINTS: Glued Clamped
2 PVC 4 ABS 6 Asbestos-Cement 9 Other (specify below) Welded
 7 Fiberglass Threaded

Blank casing diameter 5 in. to 30 ft., Dia. 5 in. to 30 ft., Dia. 5 in. to 30 ft.
 Casing height above land surface 18 in., weight 18 lbs./ft. Wall thickness or gauge No. 30R 26

TYPE OF SCREEN OR PERFORATION MATERIAL:
 1 Steel 3 Stainless steel 5 Fiberglass 8 RMP (SR) 10 Asbestos-cement
 2 Brass 4 Galvanized steel 6 Concrete tile 9 ABS 11 Other (specify) 7 PVC 12 None used (open hole)

SCREEN OR PERFORATION OPENINGS ARE:
 1 Continuous slot 3 Mill slot 5 Gauzed wrapped 8 Saw cut 11 None (open hole)
 2 Louvered shutter 4 Key punched 6 Wire wrapped 9 Drilled holes
 7 Torch cut 10 Other (specify)

SCREEN-PERFORATED INTERVALS: From 30 ft. to 40 ft., From 30 ft. to 40 ft., From 30 ft. to 40 ft.
 GRAVEL PACK INTERVALS: From 40 ft. to 20 ft., From 40 ft. to 20 ft., From 40 ft. to 20 ft.

6] GROUT MATERIAL: 1 Neat cement 2 Cement grout 3 Bentonite 4 Other
 Grout Intervals: From 20 ft. to 0 ft., From 20 ft. to 0 ft., From 20 ft. to 0 ft.

What is the nearest source of possible contamination:
 1 Septic tank 4 Lateral lines 7 Pit privy 10 Livestock pens 14 Abandoned water well
 2 Sewer lines 5 Cess pool 8 Sewage lagoon 11 Fuel storage 15 Oil well/Gas well
3 Watertight sewer lines 6 Seepage pit 9 Feedyard 12 Fertilizer storage 16 Other (specify below)
 13 Insecticide storage

Direction from well? East How many feet? 50'

FROM	TO	LITHOLOGIC LOG	FROM	TO	PLUGGING INTERVALS
0	5	loess			
5	27	1/2 brn clay			
27	37	sch. fine to med. grained			
37	40	shale			

7] CONTRACTOR'S OR LANDOWNER'S CERTIFICATION: This water well was 1 constructed, (2) reconstructed, or (3) plugged under my jurisdiction and was completed on (mo/day/year) 8-1-97 and this record is true to the best of my knowledge and belief. Kansas Water Well Contractor's License No. 608 This Water Well Record was completed on (mo/day/yr) 8-24-97 under the business name of Yellow Jacket Drilling by (signature) E. J. Weddel

OFFICE USE ONLY
T
R
EW
SEC.
1/4
1/4
1/4