


1 LOCATION OF WATER WELL: Fraction NE 1/4 SE 1/4 NW 1/4 Section Number 9 Township Number T 7 S Range Number R 7 EW  
 County: Mitchell

Distance and direction from nearest town or city street address of well if located within city?  
210 N Walnut Beloit, Ks.

2 WATER WELL OWNER: Mrs. Elizabeth Chapman  
 RR#, St. Address, Box #: 210 N. Walnut Board of Agriculture, Division of Water Resources  
 City, State, ZIP Code: Beloit, Ks 67420 Application Number:

3 LOCATE WELL'S LOCATION WITH AN "X" IN SECTION BOX: 4 DEPTH OF COMPLETED WELL: 65 ft. ELEVATION: N/A

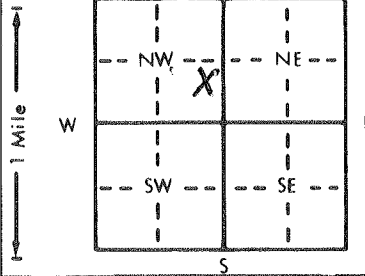

Depth(s) Groundwater Encountered 1. 38 ft. 2. 38 ft. 3. 38 ft.  
 WELL'S STATIC WATER LEVEL 38 ft. below land surface measured on mo/day/yr 8-8-97  
 Pump test data: Well water was 78.40 ft. after 2 hours pumping 1.8 gpm  
 Est. Yield 50.1 gpm: Well water was 78.40 ft. after 2 hours pumping 1.8 gpm  
 Bore Hole Diameter 10 in. to T.D ft. and 10 in. to 10 ft.  
 WELL WATER TO BE USED AS:  
 1 Domestic 3 Feedlot 6 Oil field water supply 8 Air conditioning 11 Injection well  
 2 Irrigation 4 Industrial 7 Lawn and garden only 10 Monitoring well 12 Other (Specify below)

5 TYPE OF BLANK CASING USED:  
 1 Steel 3 RMP (SR) 5 Wrought iron 8 Concrete tile CASING JOINTS: Glued  Clamped   
2 PVC 4 ABS 7 Fiberglass Welded  Threaded

Blank casing diameter 5 in. to 40 ft., Dia. 5 in. to 40 ft., Dia. 5 in. to 40 ft.  
 Casing height above land surface 18 in., weight 18 lbs./ft. Wall thickness or gauge No. SDR 26

TYPE OF SCREEN OR PERFORATION MATERIAL:  
 1 Steel 3 Stainless steel 5 Fiberglass 7 PVC 10 Asbestos-cement  
 2 Brass 4 Galvanized steel 6 Concrete tile 8 RMP (SR) 11 Other (specify) 12 None used (open hole)

SCREEN OR PERFORATION OPENINGS ARE:  
 1 Continuous slot 3 Mill slot 5 Gauzed wrapped 8 Saw cut 11 None (open hole)  
 2 Louvered shutter 4 Key punched 6 Wire wrapped 9 Drilled holes  
 7 Torch cut 10 Other (specify)

SCREEN-PERFORATED INTERVALS: From 65 ft. to 40 ft., From 40 ft. to 40 ft., From 40 ft. to 40 ft.  
 GRAVEL PACK INTERVALS: From 65 ft. to 20 ft., From 20 ft. to 20 ft., From 20 ft. to 20 ft.

6 GROUT MATERIAL: 1 Neat cement 2 Cement grout 3 Bentonite 4 Other  
 Grout Intervals: From 20 ft. to 0 ft., From 0 ft. to 0 ft., From 0 ft. to 0 ft.

What is the nearest source of possible contamination:  
 1 Septic tank 4 Lateral lines 7 Pit privy 10 Livestock pens 14 Abandoned water well  
 2 Sewer lines 5 Cess pool 8 Sewage lagoon 11 Fuel storage 15 Oil well/Gas well  
3 Watertight sewer lines 6 Seepage pit 9 Feedyard 12 Fertilizer storage 16 Other (specify below)  
 13 Insecticide storage

Direction from well? 45 East How many feet? 45

FROM	TO	LITHOLOGIC LOG	FROM	TO	PLUGGING INTERVALS
0	5	loess			
5	8	1/2 brn silty clay			
8	10	1/2 chalky wt			
10	14	1/2 gr silty sand			
14	38	1/2 brn clay			
38	62	sd med to coarse grading gravel on bottom			
62	63	weathered shale			
63	65	hard blue gray shale			

7 CONTRACTOR'S OR LANDOWNER'S CERTIFICATION: This water well was (1) constructed, (2) reconstructed, or (3) plugged under my jurisdiction and was completed on (mo/day/year) 8-8-97 and this record is true to the best of my knowledge and belief. Kansas Water Well Contractor's License No. 608 This Water Well Record was completed on (mo/day/yr) 8-24-97 under the business name of Yellow Jacket Drilling by (signature) E. J. Woodell

INSTRUCTIONS: Use typewriter or ball point pen. PLEASE PRESS FIRMLY and PRINT clearly. Please fill in blanks, underline or circle the correct answers. Send top three copies to Kansas Department of Health and Environment, Bureau of Water, Topeka, Kansas 66620-0001. Telephone: 913-296-5545. Send one to WATER WELL OWNER and retain one for your records.