

WATER WELL RECORD

Form WWC-5

Division of Water Resources App. No.


Well ID

MW6

Original Record Correction Change in Well Use

1 LOCATION OF WATER WELL: County Mitchell Fraction SE 1/4 SW 1/4 SE 1/4 SW 1/4 Section Number 4 Township Number T 7 S Range Number R 7 E X W

2 WELL OWNER: Last Name: Business: KDHE Address: 1000 SW Jackson Blvd City Topeka State KS ZIP: 66612 Street or Rural Address where well is located (if unknown, distance and direction from nearest town or intersection): If at owner's address, check here: ~50' N of 726 N. Mill, Beloit, KS

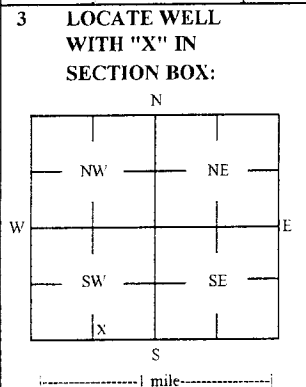

3 LOCATE WELL WITH 'X' IN SECTION BOX: 4 DEPTH OF COMPLETED WELL: 24.5 ft Depth(s) Groundwater Encountered: 1) _____ ft 2) _____ ft 3) _____ ft, or 4) Dry Well WELL'S STATIC WATER LEVEL: 9.65 ft. X below land surface, measured on (mo-day-yr) 11/3/2015

5 Latitude: 39.46647 (decimal degrees) Longitude: 98.11007 (decimal degrees) Horizontal Datum: X WGS 84 NAD 83 NAD 27 Source for Latitude/Longitude: GPS (unit make/model: _____) (WAAS enabled? Yes No) X Land Survey Topographic Map Online Mapper

6 Elevation: 1441.18 ft Ground Level: X TOC Source: X Land Survey GPS Topographic Map Other

7 WELL WATER TO BE USED AS: 1 Domestic: Household Lawn & Garden Livestock Irrigation Feedlot Industrial 5 Public Water Supply: well ID 6 Dewatering: how many wells? 7 Aquifer Recharge: well ID 8 X Monitoring: well ID MW6 9 Environmental Remediation: well ID Air Sparge Soil Vapor Extractor Recovery Injection 10 Oil Field Water Supply: lease 11 Test Hole: well ID Cased Uncased Geotechnical 12 Geothermal: How many bores? a) Closed Loop Horizontal Vertical b) Open Loop Surface Discharge Inj. of Water Other (specify):

Was a chemical/bacteriological sample submitted to KDHE? Yes No X No If yes, date sample was submitted: Water well disinfected? Yes No X No

8 TYPE OF CASING USED: Steel X PVC Other CASING JOINTS: Glued Clamped Welded X Threaded Casing diameter 2 in. to 6.5 ft. Diameter in. to ft. Diameter in. to ft. Casing height above land surface -0.30 in. Weight lbs./ft. Well thickness or gauge No TYPE OF SCREEN OR PERFORATION MATERIAL: Steel Stainless Steel Fiberglass X PVC Other (Specify) Brass Galvanized Steel Concrete tile None used (open hole) SCREEN OR PERFORATION OPENINGS ARE: Continuous Slot X Mill Slot Gauze Wrapped Torch Cut Drilled Holes Other (Specify) Louvered Shutter Key Punched Wire Wrapped Saw Cut None (Open Hole) SCREEN-PERFORATED INTERVALS: From 6.5 ft. to 24.5 ft. From ft. to ft. From ft. to ft. GRAVEL PACK INTERVALS: From 4.5 ft. to 25 ft. From ft. to ft. From ft. to ft.

9 GROUT MATERIAL: Neat cement Cement grout X Bentonite X Other Concrete: 0-1' Grout intervals: From 1 ft. to 4.5 ft. From ft. to ft. From ft. to ft.

Nearest source of possible contamination: Septic Tank Lateral Lines Pit Privy Livestock Pens Insecticide Storage Sewer Lines Cess Pool Sewage Lagoon X Fuel Storage Abandoned Water Well Watertight Sewer Lines Seepage Pit Feedyard Fertilizer Storage Oil Well / Gas Well Other (Specify) Direction from well? S Distance from well? ~90 ft

Table with columns: FROM, TO, LITHOLOGIC LOG, FROM, TO, LITHO. LOG (cont.) or PLUGGING INTERVALS. Rows: 0-0.4 Concrete, 0.4-5 Brown silty clay, 5-9 Grav silty clay, 9-10 Grav silty clay w/ limestone, 10-15 Tan to olive silty clay, 15-25 Dark gray silty clay. Notes: KDHE ID: Calhoon Automotive; U5-062-00611

11 CONTRACTOR'S OR LANDOWNER'S CERTIFICATION: This water well was X constructed, reconstructed, or plugged under my jurisdiction and was completed on (mo-day-year) 10/13/15 and this record is true to the best of my knowledge and belief. Kansas Water Well Contractor's License No 757 This Water Well Record was completed on (mo-day-year) 1/4/16 under the business name of Larsen & Associates, Inc. Signature

TRITERRA

LAND SERVICES

P.O. Box 546
Clearwater, Kansas 67026
Cell (316) 648-3617 Fax (620) 584-4371
Email: triterrals@yahoo.com

SURVEYING OF MONITORING WELLS CALHOON AUTOMOTIVE BELOIT, KANSAS

The site is located in Section 9, Township 7 South, Range 7 West of the Sixth Principal Meridian, Mitchell County, Kansas. The Southeast corner of Section 9 was assigned coordinates of 00.00 North and 00.00 West.

The vertical control was a BM described as a disk set in the center footing at the city water tower. Elevation: 1448.308' MSL. A control point was established as a chiseled 'X' on top of the sidewalk on the west side of the building on site.

The Latitude and Longitude were recorded from a GPS unit. The site is located on the 7.5' quad map titled "Beloit".

ID	NORTH	WEST	LATITUDE	LONGITUDE	ELEVATION
SE CORNER 9-7S-7W	00.00	00.00			
CP	5203.54	3512.89	39.46615	98.11019	1441.47
MW-1 NE NW NE NW	5165.98	3524.14	39.46606	98.11015	RIM 1440.65 TOC 1440.43
MW-2 NE NW NE NW	5235.09	3476.23	39.46626	98.11001	RIM 1440.98 TOC 1440.62
MW-3 NE NW NE NW	5234.99	3533.62	39.46625	98.11024	RIM 1440.04 TOC 1439.66
MW-4 NE NW NE NW	5212.69	3600.77	39.46622	98.11046	RIM 1438.09 TOC 1437.75
MW-5 NE NW NE NW	5106.46	3603.24	39.46589	98.11045	RIM 1437.72 TOC 1437.28
MW-6 (Sec 4) SE SW SE SW	5313.23	3501.07	39.46647	98.11007	RIM 1441.48 TOC 1441.18
MW-7 Sec 4) SE SW SE SW	5326.20	3374.24	39.46651	98.10963	RIM 1444.17 TOC 1443.66
MW-8 NE NW NE NW	5215.68	3332.99	39.46619	98.10950	RIM 1445.28 TOC 1444.79

