

WATER WELL RECORD

Form WWC-5

Division of Water Resources App. No.


Well ID

MW5

Original Record Correction Change in Well Ust

1 LOCATION OF WATER WELL: County Mitchell Fraction NE 1/4 NW 1/4 NE 1/4 NW 1/4 Section Number 9 Township Number T 7 S R 7 Range Number E W

2 WELL OWNER: Last Name: Business: KDHE Address: 1000 SW Jackson Blvd City Topeka State: KS ZIP: 66612 Street or Rural Address where well is located (if unknown, distance and direction from nearest town or intersection): ~70' SW of 726 N. Mill, Beloit, KS

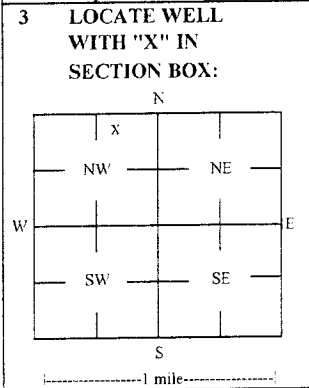

3 LOCATE WELL WITH 'X' IN SECTION BOX: 4 DEPTH OF COMPLETED WELL: 22.45 ft Depth(s) Groundwater Encountered: 1) 2) 3) 4) Dry Well WELL'S STATIC WATER LEVEL: 9.44 ft. X below land surface, measured on (mo-day-yr) 11/3/2015

5 Latitude: 39.46589 (decimal degrees) Longitude: 98.11045 (decimal degrees) Horizontal Datum: X WGS 84 NAD 83 NAD 27 Source for Latitude/Longitude: GPS (unit make/model): Land Survey Topographic Map Online Mapper

6 Elevation 1437.28 ft Ground Level X TOC Source: X Land Survey GPS Topographic Map Other

7 WELL WATER TO BE USED AS: 1 Domestic: Household Lawn & Garden Livestock Irrigation Feedlot Industrial 2 Public Water Supply: well ID 3 Dewatering: how many wells? 4 Aquifer Recharge: well ID 5 Monitoring: well ID MW5 6 Environmental Remediation: well ID 7 Air Sparge Soil Vapor Extractor 8 Recovery Injection 9 Oil Field Water Supply: lease 10 Test Hole: well ID Cased Uncased Geotechnical 11 Geothermal: How many bores? a) Closed Loop Horizontal Vertical b) Open Loop Surface Discharge Inj. of Water Other (specify):

Was a chemical/bacteriological sample submitted to KDHE? Yes No If yes, date sample was submitted: Water well disinfected? Yes No

8 TYPE OF CASING USED: Steel PVC Other CASING JOINTS: Glued Clamped Welded Threaded Casing diameter 2 in. to 7.45 ft. Diameter in. to ft. Diameter in. to ft. Casing height above land surface -0.44 in. Weight lbs./ft. Well thickness or gauge No TYPE OF SCREEN OR PERFORATION MATERIAL: Steel Stainless Steel Fiberglass PVC Other (Specify) Brass Galvanized Steel Concrete tile None used (open hole) SCREEN OR PERFORATION OPENINGS ARE: Continuous Slot Mill Slot Gauze Wrapped Torch Cut Drilled Holes Other (Specify) Louvered Shutter Key Punched Wire Wrapped Saw Cut None (Open Hole) SCREEN-PERFORATED INTERVALS: From 7.45 ft. to 22.45 ft. From ft. to ft. From ft. to ft. GRAVEL PACK INTERVALS: From 5.45 ft. to 22.7 ft. From ft. to ft. From ft. to ft.

9 GROUT MATERIAL: Neat cement Cement grout Bentonite Other Concrete: 0-1' Grout intervals: From 1 ft. to 5.45 ft. From ft. to ft. From ft. to ft.

Nearest source of possible contamination: Septic Tank Lateral Lines Pit Privy Livestock Pens Insecticide Storage Sewer Lines Cess Pool Sewage Lagoon Fuel Storage Abandoned Water Well Watertight Sewer Lines Seepage Pit Feedyard Fertilizer Storage Oil Well / Gas Well Other (Specify) Direction from well? NE Distance from well? ~100 ft

Table with 6 columns: 10 FROM, TO, LITHOLOGIC LOG, FROM, TO, LITHO. LOG (cont.) or PLUGGING INTERVALS. Rows show depth intervals and lithology: Concrete, Fill, Tan to brown silty clay, Brown silty clay, Dark brown to dark gray silty clay.

Notes: KDHC ID: Calhoon Automotive; U5-062-00611

11 CONTRACTOR'S OR LANDOWNER'S CERTIFICATION: This water well was constructed reconstructed, or plugged under my jurisdiction and was completed on (mo-day-year) 10/12/15 and this record is true to the best of my knowledge and belief. License No. 757 This Water Well Record was completed on (mo-day-year) 1/4/16 under the business name of Larsen & Associates, Inc. Signature

# TRITERRA

## LAND SERVICES

P.O. Box 546  
 Clearwater, Kansas 67026  
 Cell (316) 648-3617 Fax (620) 584-4371  
 Email: triterrals@yahoo.com

**SURVEYING OF MONITORING WELLS  
 CALHOON AUTOMOTIVE  
 BELOIT, KANSAS**

The site is located in Section 9, Township 7 South, Range 7 West of the Sixth Principal Meridian, Mitchell County, Kansas. The Southeast corner of Section 9 was assigned coordinates of 00.00 North and 00.00 West.

The vertical control was a BM described as a disk set in the center footing at the city water tower. Elevation: 1448.308' MSL. A control point was established as a chiseled 'X' on top of the sidewalk on the west side of the building on site.

The Latitude and Longitude were recorded from a GPS unit. The site is located on the 7.5' quad map titled "Beloit".

ID	NORTH	WEST	LATITUDE	LONGITUDE	ELEVATION
SE CORNER 9-7S-7W	00.00	00.00			
CP	5203.54	3512.89	39.46615	98.11019	1441.47
MW-1 NE NW NE NW	5165.98	3524.14	39.46606	98.11015	RIM 1440.65 TOC 1440.43
MW-2 NE NW NE NW	5235.09	3476.23	39.46626	98.11001	RIM 1440.98 TOC 1440.62
MW-3 NE NW NE NW	5234.99	3533.62	39.46625	98.11024	RIM 1440.04 TOC 1439.66
MW-4 NE NW NE NW	5212.69	3600.77	39.46622	98.11046	RIM 1438.09 TOC 1437.75
MW-5 NE NW NE NW	5106.46	3603.24	39.46589	98.11045	RIM 1437.72 TOC 1437.28
MW-6 (Sec 4) SE SW SE SW	5313.23	3501.07	39.46647	98.11007	RIM 1441.48 TOC 1441.18
MW-7 Sec 4) SE SW SE SW	5326.20	3374.24	39.46651	98.10963	RIM 1444.17 TOC 1443.66
MW-8 NE NW NE NW	5215.68	3332.99	39.46619	98.10950	RIM 1445.28 TOC 1444.79

