


1 LOCATION OF WATER WELL: County: Cloud Fraction: SW 1/4 SE 1/4 SE 1/4 Section Number: 17 Township Number: T 8 S Range Number: R 1 E/W

Distance and direction from nearest town or city street address of well if located within city?  
North side of property

2 WATER WELL OWNER: RR#, St. Address, Box # Jerry's Service Board of Agriculture, Division of Water Resources  
 City, State, ZIP Code 12 Ash Avenue, Miltonvale, Ks Application Number: -----

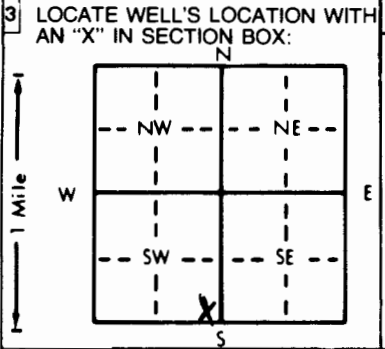

4 DEPTH OF COMPLETED WELL: 20 35 ft. ELEVATION: -----  
 Depth(s) Groundwater Encountered 1. 29 ft. 2. ----- ft. 3. ----- ft.  
 WELL'S STATIC WATER LEVEL 28.48 ft. below land surface measured on mo/day/yr 9/15/95 3.596  
 Pump test data: Well water was ----- ft. after ----- hours pumping ----- gpm  
 Est. Yield ----- gpm: Well water was ----- ft. after ----- hours pumping ----- gpm  
 Bore Hole Diameter 8.625 in. to 35 ft., and ----- in. to ----- ft.  
 WELL WATER TO BE USED AS: 5 Public water supply 8 Air conditioning 11 Injection well  
 1 Domestic 3 Feedlot 6 Oil field water supply 9 Dewatering 12 Other (Specify below)  
 2 Irrigation 4 Industrial 7 Lawn and garden only 10 Monitoring well mw-3  
 Was a chemical/bacteriological sample submitted to Department? Yes ----- No X; If yes, mo/day/yr sample was submitted -----  
 Water Well Disinfected? Yes ----- No X

5 TYPE OF BLANK CASING USED: 1 Steel 3 RMP (SR) 5 Wrought iron 8 Concrete tile CASING JOINTS: Glued ----- Clamped -----  
2 PVC 4 ABS 6 Asbestos-Cement 9 Other (specify below) Welded -----  
 7 Fiberglass Threaded X  
 Blank casing diameter 2 in. to 20 ft., Dia ----- in. to ----- ft., Dia ----- in. to ----- ft.  
 Casing height above land surface 0 in., weight SCH 40 PVC lbs./ft. Wall thickness or gauge No. -----  
 TYPE OF SCREEN OR PERFORATION MATERIAL: 7 PVC 10 Asbestos-cement  
 1 Steel 3 Stainless steel 5 Fiberglass 8 RMP (SR) 11 Other (specify) -----  
 2 Brass 4 Galvanized steel 6 Concrete tile 9 ABS 12 None used (open hole)  
 SCREEN OR PERFORATION OPENINGS ARE: 5 Gauzed wrapped 8 Saw cut 11 None (open hole)  
 1 Continuous slot 3 Mill slot 6 Wire wrapped 9 Drilled holes  
 2 Louvered shutter 4 Key punched 7 Torch cut 10 Other (specify) -----  
 SCREEN-PERFORATED INTERVALS: From 20 ft. to 35 ft., From ----- ft. to ----- ft.  
 GRAVEL PACK INTERVALS: From 19 ft. to 35 ft., From ----- ft. to ----- ft.

6 GROUT MATERIAL 2 1 Neat cement 2 Cement grout 3 Bentonite 3 Other -----  
 Grout Intervals: From 0 ft. to 17 ft., From 3 ft. to 17 ft., From 19 ft. to ----- ft.  
 What is the nearest source of possible contamination: 10 Livestock pens 14 Abandoned water well  
 1 Septic tank 4 Lateral lines 7 Pit privy 11 Fuel storage 15 Oil well/Gas well  
 2 Sewer lines 5 Cess pool 8 Sewage lagoon 12 Fertilizer storage 16 Other (specify below)  
 3 Watertight sewer lines 6 Seepage pit 9 Feedyard 13 Insecticide storage Contaminated Si  
 Direction from well? ----- How many feet? -----

FROM	TO	LITHOLOGIC LOG	FROM	TO	PLUGGING INTERVALS
GL	10.00	Topsoil, grading to clay			
10.00	15.00	Clay, silt, orange-red to white-gray			
15.00	20.00	Clay, weathered shale with sand			
20.00	35.00	Sand, fine to med.			
35.00	TD	End of borehole			
					Flush Mount waiver D. Taylor

7 CONTRACTOR'S OR LANDOWNER'S CERTIFICATION: This water well was (1 constructed), (2) reconstructed, or (3) plugged under my jurisdiction and was completed on (mo/day/year) 3/5/96 and this record is true to the best of my knowledge and belief. Kansas Water Well Contractor's License No. 585 This Water Well Record was completed on (mo/day/yr) 4/5/96 under the business name of Associated Environmental, Inc. by (signature) Johnson for Dawn Duncan

INSTRUCTIONS: Use typewriter or ball point pen. PLEASE PRESS FIRMLY and PRINT clearly. Please fill in blanks, underline or circle the correct answers. Send top three copies to Kansas Department of Health and Environment, Bureau of Water, Topeka, Kansas 66620-0001. Telephone: 913-296-5545. Send one to WATER WELL OWNER and retain one for your records.