

MW13

1 LOCATION OF WATER WELL: County: <u>Cloud</u>	Fraction: <u>NE 1/4 NW 1/4 NE 1/4</u>	Section Number: <u>20</u>	Township Number: <u>T 08 S</u>	Range Number: <u>R 01 E</u>
---	---------------------------------------	---------------------------	--------------------------------	-----------------------------

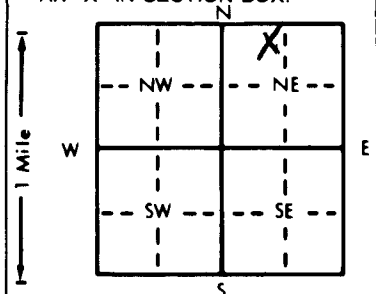
Distance and direction from nearest town or city street address of well if located within city?

12 Ash Avenue Miltonvale KS2 WATER WELL OWNER: Jerry GrahamRR#, St. Address, Box #: P.O. Box 272City, State, ZIP Code: Miltonvale KS 67466

Board of Agriculture, Division of Water Resources

Application Number:

3 LOCATE WELL'S LOCATION WITH AN "X" IN SECTION BOX:

4 DEPTH OF COMPLETED WELL: 28 ft. ELEVATION: 1389.42Depth(s) Groundwater Encountered 1. 23 ft. 2. ft. 3. ft.WELL'S STATIC WATER LEVEL 22.62 ft. below land surface measured on mo/day/yr 05/19/1999

Pump test data: Well water was ft. after hours pumping gpm

Est. Yield gpm: Well water was ft. after hours pumping gpm

Bore Hole Diameter: 8.5 in. to 30 in. to in. to ft.

WELL WATER TO BE USED AS: 5 Public water supply 8 Air conditioning 11 Injection well

1 Domestic 3 Feedlot 6 Oil field water supply 9 Dewatering 12 Other (Specify below)

2 Irrigation 4 Industrial 7 Lawn and garden only 10 Monitoring well MW13Was a chemical/bacteriological sample submitted to Department? Yes No X; If yes, mo/day/yr sample was submittedWater Well Disinfected? Yes No

5 TYPE OF BLANK CASING USED:

1 Steel 3 RMP (SR) 5 Wrought iron 8 Concrete tile CASING JOINTS: Glued Clamped

2 PVC 4 ABS 6 Asbestos-Cement 9 Other (specify below) Welded

Blank casing diameter 2 in. to 18 ft. Dia. in. to ft. Dia. in. to ft.Casing height above land surface 8.76 in. weight 2.067 lbs./ft. Wall thickness or gauge No. SCH 40

TYPE OF SCREEN OR PERFORATION MATERIAL:

1 Steel 3 Stainless steel 5 Fiberglass 8 RMP (SR) 10 Asbestos-cement

2 Brass 4 Galvanized steel 6 Concrete tile 9 ABS 11 Other (specify)

SCREEN OR PERFORATION OPENINGS ARE: 5 Gauzed wrapped 8 Saw cut 11 None (open hole)

1 Continuous slot 3 Mill slot 6 Wire wrapped 9 Drilled holes

2 Louvered shutter 4 Key punched 7 Torch cut 10 Other (specify)

SCREEN-PERFORATED INTERVALS: From 18 ft. to 28 ft. From ft. to ft.

From ft. to ft. From ft. to ft.

GRAVEL PACK INTERVALS: From 16 ft. to 30 ft. From ft. to ft.

From ft. to ft. From ft. to ft.

6 GROUT MATERIAL: 1 Neat cement 2 Cement grout 3 Bentonite 4 Other

Grout Intervals: From 1 ft. to 16 ft. From ft. to ft. From ft. to ft.

What is the nearest source of possible contamination:

1 Septic tank 4 Lateral lines 7 Pit privy 10 Livestock pens 14 Abandoned water well

2 Sewer lines 5 Cess pool 8 Sewage lagoon 11 Fuel storage 15 Oil well/Gas well

3 Watertight sewer lines 6 Seepage pit 9 Feedyard 12 Fertilizer storage 16 Other (specify below)

Direction from well? How many feet? Last Site

FROM TO LITHOLOGIC LOG FROM TO PLUGGING INTERVALS

0 1 Topsoil

1 15 Silty Clay

15 20 Clayey Silt

20 30 Sand

INSTRUCTIONS: Use typewriter or ball point pen. PLEASE PRESS FIRMLY and PRINT clearly. Please fill in blanks, underline or circle the correct answers. Send top three copies to Kansas Department of Health and Environment, Bureau of Water, Topeka, Kansas 66620-0001. Telephone: 913-296-5545. Send one to WATER WELL OWNER and retain one for your records.

7 CONTRACTOR'S OR LANDOWNER'S CERTIFICATION: This water well was (1) constructed, (2) reconstructed, or (3) plugged under my jurisdiction and was completed on (mo/day/year) 5/12/97 and this record is true to the best of my knowledge and belief. KansasWater Well Contractor's License No. 594 This Water Well Record was completed on (mo/day/yr) 5/26/99under the business name of Coranco Great Plains by (signature) Walter F. Mahle

OFFICE USE ONLY

T

R

EW

SEC.

1/4

1/4

1/4