


1 LOCATION OF WATER WELL: County: Cloud	Fraction NW 1/4 NE 1/4 NE 1/4	Section Number 20	Township Number T 08 S	Range Number R 01 E/W
---	---	-----------------------------	----------------------------------	---------------------------------

Distance and direction from nearest town or city street address of well if located within city?

15 Ash Street

2 WATER WELL OWNER: Max Begnoch RR#, St. Address, Box #: P.O. Box 145 City, State, ZIP Code: Miltonvale KS 67466	Board of Agriculture, Division of Water Resources Application Number:
---	--

3 LOCATE WELL'S LOCATION WITH AN "X" IN SECTION BOX:

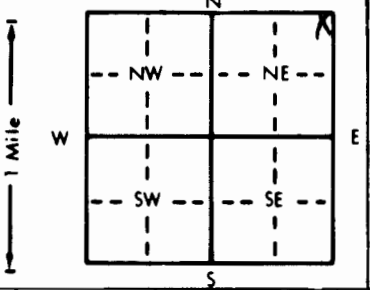

4 DEPTH OF COMPLETED WELL: 20 ft. ELEVATION: 1377.47
Depth(s) Groundwater Encountered 1. 15 ft. 2. _____ ft. 3. _____ ft.
WELL'S STATIC WATER LEVEL 15.88 ft. below land surface measured on mo/day/yr 9/8/99
Pump test data: Well water was _____ ft. after _____ hours pumping _____ gpm
Est. Yield _____ gpm: Well water was _____ ft. after _____ hours pumping _____ gpm
Bore Hole Diameter: 10.5 in. to 20 ft., and _____ in. to _____ ft.
WELL WATER TO BE USED AS:
1 Domestic 3 Feedlot 6 Oil field water supply 9 Dewatering 12 Other (Specify below) 2 Irrigation 4 Industrial 7 Lawn and garden only 10 Monitoring well X VOBWS
Was a chemical/bacteriological sample submitted to Department? Yes _____ No X ; If yes, mo/day/yr sample was sub-mitted _____
Water Well Disinfected? Yes _____ No (X)

5 TYPE OF BLANK CASING USED:	5 Wrought iron	8 Concrete tile	CASING JOINTS: Glued _____ Clamped _____
1 Steel	3 RMP (SR)	6 Asbestos-Cement	9 Other (specify below)
2 PVC	4 ABS	7 Fiberglass	Welded _____
Blank casing diameter 4 in. to 5 ft., Dia _____ in. to _____ ft., Dia _____ in. to _____ ft.			Threaded _____
Casing height above land surface -7.8 in., weight _____ lbs./ft. Wall thickness or gauge No. _____			
TYPE OF SCREEN OR PERFORATION MATERIAL:		7 PVC	10 Asbestos-cement
1 Steel	3 Stainless steel	5 Fiberglass	8 RMP (SR)
2 Brass	4 Galvanized steel	6 Concrete tile	9 ABS
SCREEN OR PERFORATION OPENINGS ARE:		5 Gauzed wrapped	8 Saw cut
1 Continuous slot	9 Mill slot	6 Wire wrapped	9 Drilled holes
2 Louvered shutter	4 Key punched	7 Torch cut	10 Other (specify) _____
SCREEN-PERFORATED INTERVALS: From 5 ft. to 20 ft., From _____ ft. to _____ ft.			
GRAVEL PACK INTERVALS: From 5 ft. to 20 ft., From _____ ft. to _____ ft.			

6 GROUT MATERIAL: Neat cement	2 Cement grout	3 Bentonite	4 Other _____
Grout Intervals: From 1 ft. to 4 ft., From _____ ft. to _____ ft., From _____ ft. to _____ ft.			
What is the nearest source of possible contamination:		10 Livestock pens	14 Abandoned water well
1 Septic tank	4 Lateral lines	7 Pit privy	11 Fuel storage
2 Sewer lines	5 Cess pool	8 Sewage lagoon	12 Fertilizer storage
3 Watertight sewer lines	6 Seepage pit	9 Feedyard	13 Insecticide storage
			16 Other (specify below) Last site

FROM	TO	LITHOLOGIC LOG	FROM	TO	PLUGGING INTERVALS
0	20	Clay			

7 CONTRACTOR'S OR LANDOWNER'S CERTIFICATION: This water well was **(1)** constructed, (2) reconstructed, or (3) plugged under my jurisdiction and was completed on (mo/day/year) **8/18/99** and this record is true to the best of my knowledge and belief. Kansas Water Well Contractor's License No. **594**. This Water Well Record was completed on (mo/day/yr) **9/27/99** under the business name of **Coranco Great Plains** by (signature) **Toby J. Mohr**

OFFICE USE ONLY
T
R
EW
SEC
1/4
1/4
1/4