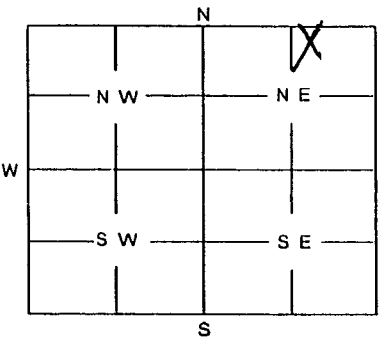


1	LOCATION OF WATER WELL: County: Cloud	Fraction NW 1/4 NE 1/4 NE 1/4	Section Number 20	Township Number 8 S	Range Number 1 W
---	--	----------------------------------	----------------------	------------------------	---------------------

Distance and direction from nearest town or city street address of well if located within city?
15 Ash Street, Miltonvale, Kansas

2	WATER WELLOWNER: Max Begnoche P.O. Box 145 RR #, St. Address, Box #: Miltonvale, KS 67466 City, State, ZIP Code :	Board of Agriculture, Division of Water Resources Application Number:
---	--	--

3	MARK WELL'S LOCATION WITH AN "X" IN SECTION BOX: 	4	DEPTH OF WELL 20 ft WELL'S STATIC WATER LEVEL 15.7 ft WELL WAS USED AS: 1 Domestic 5 Public Water Supply 9 Dewatering 2 Irrigation 6 Oil Field Water Supply 10 Monitoring Well 3 Feedlot 7 Domestic (Lawn & Garden) 11 Injection Well 4 Industrial 8 Air Conditioning 12 Other Was a chemical / bacteriological sample submitted to Department? Yes No X If yes, mo/day/yr sample was submitted Water Well Disinfected: Yes No X
---	---	---	---

5	TYPE OF BLANK CASING USED: 1 Steel 3 RMP (SR) 5 Wrought 7 Fiberglass 9 Other (Specify below) 2 PVC 4 ABS 6 Asbestos-Cement 8 Concrete Tile Blank casing diameter 4 in. Was casing pulled? Yes X No Casing height above or below land surface n/a in. If yes, how much
---	--

6	GROUT PLUG MATERIAL: 1 Neat cement 2 Cement grout 3 Bentonite 4 Other native soil Grout Plug Intervals: From 0 ft. to 2 ft., From 2 ft. to 15 ft., From to ft. What is the nearest source of possible contamination: 1 Septic tank 6 Seepage pit 11 Fuel storage 16 Other (specify below) 2 Sewer lines 7 Pit privy 12 Fertilizer storage ...UST...basin..... 3 Watertight sewer lines 8 Sewage lagoon 13 Insecticide storage 4 Lateral lines 9 Feedyard 14 Abandoned water well 5 Cess Pool 10 Livestock pens 15 Oil well/Gas well Direction from well? SSE How many feet? 60
---	--

FROM	TO	PLUGGING MATERIALS
0	2	Native soil
2	15	Bentonite

Drilled out to 15'
with 8.25" O.D. auger

GeoCore Project #976
Well #VOBW4

7	CONTRACTOR'S OR LANDOWNER'S CERTIFICATION: This water well was plugged under my jurisdiction and was completed on (mo/day/year) 11/5/2003 and this record is true to the best of my knowledge and belief. Kansas Water Well Contractor's License No. 527 This Water Well Record was completed on (mo/day/year) 11/21/2003 under the business name of GeoCore, Inc. by (signature) <i>Dale Hill</i>
---	--

INSTRUCTIONS: Use typewriter or ball point pen. Please press firmly and print clearly. Please fill in blanks, underline or circle the correct answers. Send top three copies to Kansas Department of Health and Environment, Bureau of Water, Topeka, Kansas 66620-0001. Telephone: 785/296-3565. Send one to Water Well Owner and retain one for your records.