


1 LOCATION OF WATER WELL: County: MITCHELL Fraction: SE 1/4 SW 1/4 SW 1/4 Section Number: 20 Township Number: T 8 S Range Number: R 10 EW

Distance and direction from nearest town or city street address of well if located within city? 1/2 BELOW RW-8

2 WATER WELL OWNER: FARMWAY COOP
 RR#, St. Address, Box #: WASHINGTON & BUFFALO
 City, State, ZIP Code: TIPTON, KS 67485
 Board of Agriculture, Division of Water Resources
 Application Number: _____

3 LOCATE WELL'S LOCATION WITH AN "X" IN SECTION BOX:

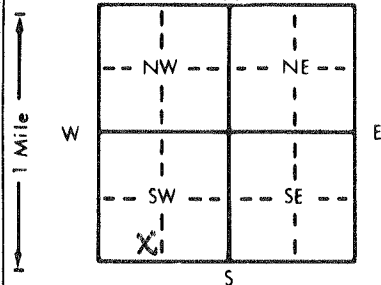

4 DEPTH OF COMPLETED WELL: 35 ft. ELEVATION: 1585.54

Depth(s) Groundwater Encountered 1. _____ ft. 2. _____ ft. 3. _____ ft.
 WELL'S STATIC WATER LEVEL 24.50 ft. below land surface measured on mo/day/yr 5-11-95
 Pump test data: Well water was _____ ft. after _____ hours pumping _____ gpm
 Est. Yield _____ gpm: Well water was _____ ft. after _____ hours pumping _____ gpm
 Bore Hole Diameter 11 in. to _____ ft., and _____ in. to _____ ft.
 WELL WATER TO BE USED AS:
 5 Public water supply 8 Air conditioning 11 Injection well
 1 Domestic 3 Feedlot 6 Oil field water supply 9 Dewatering 12 Other (Specify below)
 2 Irrigation 4 Industrial 7 Lawn and garden only 10 Monitoring well
 Was a chemical/bacteriological sample submitted to Department? Yes (No); If yes, mo/day/yr sample was submitted _____
 Water Well Disinfected? Yes (No)

5 TYPE OF BLANK CASING USED:

1 Steel 3 RMP (SR) 5 Wrought iron 8 Concrete tile CASING JOINTS: Glued _____ Clamped _____
2 PVC 4 ABS 6 Asbestos-Cement 9 Other (specify below) Welded _____
 7 Fiberglass (Threaded)
 Blank casing diameter 4 in. to 20 ft., Dia _____ in. to _____ ft., Dia _____ in. to _____ ft.
 Casing height above land surface 0 in., weight _____ lbs./ft. Wall thickness or gauge No. SC# 40

TYPE OF SCREEN OR PERFORATION MATERIAL:
 1 Steel 3 Stainless steel 5 Fiberglass 7 PVC 10 Asbestos-cement
 2 Brass 4 Galvanized steel 6 Concrete tile 8 RMP (SR) 11 Other (specify) _____
 9 ABS 12 None used (open hole)

SCREEN OR PERFORATION OPENINGS ARE:
 1 Continuous slot 3 Mill slot 5 Gauzed wrapped 8 Saw cut 11 None (open hole)
 2 Louvered shutter 4 Key punched 6 Wire wrapped 9 Drilled holes
 7 Torch cut 10 Other (specify) _____

SCREEN-PERFORATED INTERVALS: From 20 ft. to 35 ft., From _____ ft. to _____ ft.
 From _____ ft. to _____ ft., From _____ ft. to _____ ft.
 GRAVEL PACK INTERVALS: From 17 ft. to 35 ft., From _____ ft. to _____ ft.
 From _____ ft. to _____ ft., From _____ ft. to _____ ft.

6 GROUT MATERIAL: 1 Neat cement 2 Cement grout 3 Bentonite 4 Other _____

Grout Intervals: From 2 ft. to 0 ft., From 2 ft. to 17 ft., From _____ ft. to _____ ft.
 What is the nearest source of possible contamination:
 1 Septic tank 4 Lateral lines 7 Pit privy 11 Fuel storage 14 Abandoned water well
 2 Sewer lines 5 Cess pool 8 Sewage lagoon 12 Fertilizer storage 15 Oil well/Gas well
 3 Watertight sewer lines 6 Seepage pit 9 Feedyard 13 Insecticide storage 16 Other (specify below) _____

Direction from well? NW How many feet? 15

FROM	TO	LITHOLOGIC LOG	FROM	TO	PLUGGING INTERVALS
0	10	LOESS BRN			
10	22	a.a. TR CHALKY GRAVEL			
22	34.5	a.a. W/ CHALKY GRAVEL			
34.5	35	DARK GRY SHALE			

7 CONTRACTOR'S OR LANDOWNER'S CERTIFICATION: This water well was (1) constructed, (2) reconstructed, or (3) plugged under my jurisdiction and was completed on (mo/day/year) 5-11-95 and this record is true to the best of my knowledge and belief. Kansas Water Well Contractor's License No. 534 This Water Well Record was completed on (mo/day/yr) 6-12-95 under the business name of AGD SERVICES by (signature) Jay C. [Signature]