


1 LOCATION OF WATER WELL: County: MITCHELL Fraction: SE 1/4 SW 1/4 SW 1/4 Section Number: 20 Township Number: T 8 S Range Number: R 10 E/W

Distance and direction from nearest town or city street address of well if located within city?  
AS BELOW

2 WATER WELL OWNER: FARMAY COOP RR#, St. Address, Box #: WASHINGTON & BUFFALO City, State, ZIP Code: TIPTON, KS 67485 Board of Agriculture, Division of Water Resources Application Number: RW-3

3 LOCATE WELL'S LOCATION WITH AN "X" IN SECTION BOX:

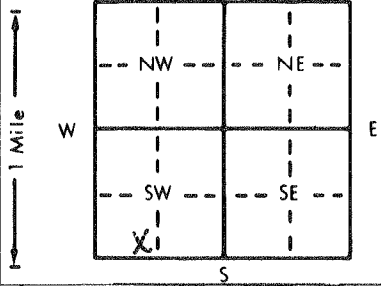

4 DEPTH OF COMPLETED WELL: 35 ft. ELEVATION: 1586.05

Depth(s) Groundwater Encountered 1. . . . . ft. 2. . . . . ft. 3. . . . . ft.  
WELL'S STATIC WATER LEVEL 25.18 ft. below land surface measured on mo/day/yr 5-11-95  
Pump test data: Well water was . . . . . ft. after . . . . . hours pumping . . . . . gpm  
Est. Yield . . . . . gpm: Well water was . . . . . ft. after . . . . . hours pumping . . . . . gpm  
Bore Hole Diameter: 11 in. to . . . . . ft., and . . . . . in. to . . . . . ft.  
WELL WATER TO BE USED AS: 5 Public water supply 8 Air conditioning 11 Injection well  
1 Domestic 3 Feedlot 6 Oil field water supply 9 Dewatering 12 Other (Specify below)  
2 Irrigation 4 Industrial 7 Lawn and garden only 10 Monitoring well . . . . .  
Was a chemical/bacteriological sample submitted to Department? Yes (No); If yes, mo/day/yr sample was submitted  
Water Well Disinfected? Yes (No)

5 TYPE OF BLANK CASING USED: 1 Steel 3 RMP (SR) 5 Wrought iron 8 Concrete tile CASING JOINTS: Glued . . . . . Clamped . . . . .  
2 PVC 4 ABS 6 Asbestos-Cement 9 Other (specify below) Welded . . . . .  
Blank casing diameter 4 in. to 20 ft., Dia . . . . . in. to . . . . . ft., Dia . . . . . in. to . . . . . ft.  
Casing height above land surface: 0 in., weight . . . . . lbs./ft. Wall thickness or gauge No. SCR 40  
7 Fiberglass . . . . . Threaded. X

TYPE OF SCREEN OR PERFORATION MATERIAL: 1 Steel 3 Stainless steel 5 Fiberglass 8 RMP (SR) 10 Asbestos-cement  
2 Brass 4 Galvanized steel 6 Concrete tile 9 ABS 11 Other (specify) . . . . .  
12 None used (open hole)

SCREEN OR PERFORATION OPENINGS ARE: 1 Continuous slot 3 Mill slot 5 Gauzed wrapped 8 Saw cut 11 None (open hole)  
2 Louvered shutter 4 Key punched 6 Wire wrapped 9 Drilled holes  
7 Torch cut 10 Other (specify) . . . . .

SCREEN-PERFORATED INTERVALS: From 20 ft. to 35 ft., From . . . . . ft. to . . . . . ft.  
From . . . . . ft. to . . . . . ft., From . . . . . ft. to . . . . . ft.  
GRAVEL PACK INTERVALS: From 18 ft. to 35 ft., From . . . . . ft. to . . . . . ft.  
From . . . . . ft. to . . . . . ft., From . . . . . ft. to . . . . . ft.

6 GROUT MATERIAL: 1 Neat cement 2 Cement grout 3 Bentonite 4 Other . . . . .  
Grout Intervals: From 2 ft. to 0 ft., From 18 ft. to 2 ft., From . . . . . ft. to . . . . . ft.  
What is the nearest source of possible contamination: 1 Septic tank 4 Lateral lines 7 Pit privy 11 Fuel storage 14 Abandoned water well  
2 Sewer lines 5 Cess pool 8 Sewage lagoon 12 Fertilizer storage 15 Oil well/Gas well  
3 Watertight sewer lines 6 Seepage pit 9 Feedyard 13 Insecticide storage 16 Other (specify below)  
Direction from well? E How many feet? 15

FROM	TO	LITHOLOGIC LOG	FROM	TO	PLUGGING INTERVALS
0	22	BRN LOESS			
22	23	a.a. W/CHALKY GRAVEL			
23	33	LOESS a.a.			
33	35	GRY/GRN SHALE			

7 CONTRACTOR'S OR LANDOWNER'S CERTIFICATION: This water well was (1) constructed, (2) reconstructed, or (3) plugged under my jurisdiction and was completed on (mo/day/year) 5-14-95 and this record is true to the best of my knowledge and belief. Kansas Water Well Contractor's License No. 554 This Water Well Record was completed on (mo/day/yr) 5-12-95 under the business name of AGD SERVICES by (signature) July G. Wright