


1 LOCATION OF WATER WELL: Fraction Section Number Township Number Range Number  
 County: Mitchell SE 1/4 SW 1/4 SW 1/4 20 T 8 S R 10 EW

Distance and direction from nearest town or city street address of well if located within city?  
 SE corner Tipton (108 S. Washington), NW area of property

2 WATER WELL OWNER:  
 RR#, St. Address, Box # Farmway Coop Bulk Plant Board of Agriculture, Division of Water Resources  
 City, State, ZIP Code P.O. Box 568, Beloit, KS 67420 Application Number:

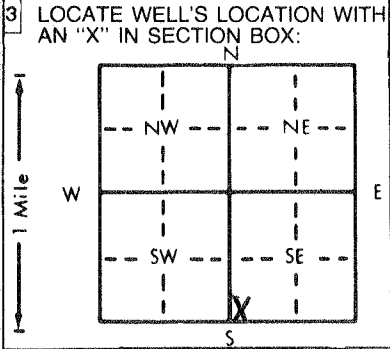

4 DEPTH OF COMPLETED WELL: 35 ft. ELEVATION:  
 Depth(s) Groundwater Encountered 1. 26 ft. 2. ft. 3. ft.  
 WELL'S STATIC WATER LEVEL: dry ft. below land surface measured on mo/day/yr 9/13/95 3-14-96  
 Pump test data: Well water was ft. after hours pumping gpm  
 Est. Yield gpm: Well water was ft. after hours pumping gpm  
 Bore Hole Diameter: 8.625 in. to ft., and in. to ft.  
 WELL WATER TO BE USED AS:  
 5 Public water supply 8 Air conditioning 11 Injection well  
 1 Domestic 3 Feedlot 6 Oil field water supply 9 Dewatering 12 Other (Specify below)  
 2 Irrigation 4 Industrial 7 Lawn and garden only 10 Monitoring well  
 Was a chemical/bacteriological sample submitted to Department? Yes No X; If yes, mo/day/yr sample was submitted Water Well Disinfected? Yes No X

5 TYPE OF BLANK CASING USED:  
 1 Steel 3 RMP (SR) 5 Wrought iron 8 Concrete tile CASING JOINTS: Glued Clamped  
 2 PVC 4 ABS 6 Asbestos-Cement 9 Other (specify below) Welded  
 7 Fiberglass Threaded X  
 Blank casing diameter 4 in. to 20 ft., Dia in. to ft., Dia in. to ft.  
 Casing height above land surface 0 in., weight SCH 40 PVC lbs./ft. Wall thickness or gauge No.  
 TYPE OF SCREEN OR PERFORATION MATERIAL:  
 1 Steel 3 Stainless steel 5 Fiberglass 8 RMP (SR) 10 Asbestos-cement  
 2 Brass 4 Galvanized steel 6 Concrete tile 9 ABS 12 None used (open hole)  
 SCREEN OR PERFORATION OPENINGS ARE:  
 1 Continuous slot 3 Mill slot 5 Gauzed wrapped 8 Saw cut 11 None (open hole)  
 2 Louvered shutter 4 Key punched 6 Wire wrapped 9 Drilled holes  
 7 Torch cut 10 Other (specify)  
 SCREEN-PERFORATED INTERVALS: From 20 ft. to 35 ft., From ft. to ft.  
 SAND GRAVEL PACK INTERVALS: From 19 ft. to 35 ft., From ft. to ft.

6 GROUT MATERIAL:  
 1 Neat cement 2 Cement grout 3 Bentonite 4 Other  
 Grout Intervals: From 0 ft. to 1.7 ft., From 1.7 ft. to 1.9 ft., From ft. to ft.  
 What is the nearest source of possible contamination:  
 1 Septic tank 4 Lateral lines 7 Pit privy 10 Livestock pens 14 Abandoned water well  
 2 Sewer lines 5 Cess pool 8 Sewage lagoon 11 Fuel storage 15 Oil well/Gas well  
 3 Watertight sewer lines 6 Seepage pit 9 Feedyard 12 Fertilizer storage 16 Other (specify below)  
 13 Insecticide storage Contaminated Si  
 Direction from well? How many feet?

FROM	TO	LITHOLOGIC LOG	FROM	TO	PLUGGING INTERVALS
GL	2.00	Fill, gavel, topsoil			
2.00	10.00	Clay, silt brown, moist, hard			
10.00	15.00	Clay, dark brown, trace limestone			
15.00	25.00	Clay, brown, minor silt, trace limestone			
25.00	30.00	Limestone and chert nodules			
35.00	35.00	Clay, brown with green tint, minor silt, moist			
35.00	35.00	Shale, gray to orange, moist			
35.00	TD	End of borehole			
					Flush Mount waiver D. Taylor

7 CONTRACTOR'S OR LANDOWNER'S CERTIFICATION: This water well was (1) constructed, (2) reconstructed, or (3) plugged under my jurisdiction and was completed on (mo/day/year) 3/15/96 and this record is true to the best of my knowledge and belief. Kansas Water Well Contractor's License No. 585 This Water Well Record was completed on (mo/day/yr) 4/5/96 under the business name of Associated Environmental, Inc. by (signature) D. Taylor