


1 LOCATION OF WATER WELL: Fraction SE 1/4 NE 1/4 SE 1/4 Section Number 19 Township Number T 8 S Range Number R 10 (EW)
 County: Mitchell

Distance and direction from nearest town or city street address of well if located within city?
sw corner of Main and Frederick, Tipton, KS

2 WATER WELL OWNER: Farmway Coop, Inc. Attn: C. Hesseflow
 RR#, St. Address, Box #: P.O. Box 568 Board of Agriculture, Division of Water Resources
 City, State, ZIP Code: Beloit, KS 67420 Application Number: ---

3 LOCATE WELL'S LOCATION WITH AN "X" IN SECTION BOX:

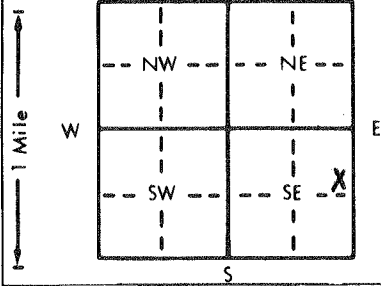

4 DEPTH OF COMPLETED WELL: 46.0 ft. ELEVATION: ---
 Depth(s) Groundwater Encountered 1. 36.0 ft. 2. --- ft. 3. --- ft.
 WELL'S STATIC WATER LEVEL: 37.23 ft. below land surface measured on mo/day/yr 11-17-94
 Pump test data: Well water was --- ft. after --- hours pumping --- gpm
 Est. Yield --- gpm: Well water was --- ft. after --- hours pumping --- gpm
 Bore Hole Diameter: 8.625 in. to 46 ft., and --- in. to --- ft.

WELL WATER TO BE USED AS:
 5 Public water supply 8 Air conditioning 11 Injection well
 1 Domestic 3 Feedlot 6 Oil field water supply 9 Dewatering 12 Other (Specify below)
 2 Irrigation 4 Industrial 7 Lawn and garden only 10 Monitoring well MW-2
 Was a chemical/bacteriological sample submitted to Department? Yes --- No X; If yes, mo/day/yr sample was submitted ---
 Water Well Disinfected? Yes --- No X

5 TYPE OF BLANK CASING USED:
 1 Steel 3 RMP (SR) 5 Wrought iron 8 Concrete tile CASING JOINTS: Glued --- Clamped ---
2 PVC 4 ABS 6 Asbestos-Cement 9 Other (specify below) Welded ---
 7 Fiberglass Threaded X

Blank casing diameter: 2 in. to 30.5 ft., Dia. --- in. to --- ft., Dia. --- in. to --- ft.
 Casing height above land surface: 0 in., weight Sch. 40 lbs./ft. Wall thickness or gauge No. ---

TYPE OF SCREEN OR PERFORATION MATERIAL:
 1 Steel 3 Stainless steel 5 Fiberglass 8 RMP (SR) 10 Asbestos-cement
 2 Brass 4 Galvanized steel 6 Concrete tile 9 ABS 11 Other (specify) ---
 12 None used (open hole)

SCREEN OR PERFORATION OPENINGS ARE:
 1 Continuous slot 3 Mill slot 5 Gauzed wrapped 8 Saw cut 11 None (open hole)
 2 Louvered shutter 4 Key punched 6 Wire wrapped 9 Drilled holes
 7 Torch cut 10 Other (specify) ---

SCREEN-PERFORATED INTERVALS: From 30.5 ft. to 45.5 ft., From --- ft. to --- ft.
 SAND GRAVEL PACK INTERVALS: From 29.5 ft. to 46.0 ft., From --- ft. to --- ft.

6 GROUT MATERIAL: 2 Neat cement 3 Cement grout 3 Bentonite 4 Other ---
 Grout Intervals: From 0 ft. to 27.5 ft., From 27.5 ft. to 29.5 ft., From --- ft. to --- ft.

What is the nearest source of possible contamination:
 1 Septic tank 4 Lateral lines 7 Pit privy 10 Livestock pens 14 Abandoned water well
 2 Sewer lines 5 Cess pool 8 Sewage lagoon 11 Fuel storage 15 Oil well/Gas well
 3 Watertight sewer lines 6 Seepage pit 9 Feedyard 12 Fertilizer storage 16 Other (specify below) Contaminated site
 13 Insecticide storage

Direction from well? --- How many feet? ---

FROM	TO	LITHOLOGIC LOG	FROM	TO	PLUGGING INTERVALS
0	1.0	concrete			
1.0'	38.5	Silty clay			
38.5	44.0	Limestone sand and gravel			
44.0	46.0	Silty clay, brown			
46.0	TD				
FLUSH MOUNT WAIVER 09-26-94 DON TAYLOR					

7 CONTRACTOR'S OR LANDOWNER'S CERTIFICATION: This water well was (1) constructed, (2) reconstructed, or (3) plugged under my jurisdiction and was completed on (mo/day/year) 10-19-94 and this record is true to the best of my knowledge and belief. Kansas Water Well Contractor's License No. 479 This Water Well Record was completed on (mo/day/yr) 11-21-94 under the business name of EBBERTS DRILLING by (signature) Morgan Ebberts