


1 LOCATION OF WATER WELL: Fraction SE 1/4 NE 1/4 SE 1/4 Section Number 19 Township Number T 8 S Range Number R 10 EW
 County: Mitchell

Distance and direction from nearest town or city street address of well if located within city?
50' S of SW corner of Main + Frederick, Tipton, KS

2 WATER WELL OWNER: Farmway Coop. Inc. Attn. C. Hessenflow
 RR#, St. Address, Box #: P.O. Box 568 Board of Agriculture, Division of Water Resources
 City, State, ZIP Code: Beloit, KS 67420 Application Number:

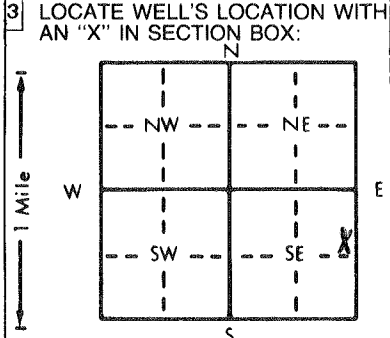

4 DEPTH OF COMPLETED WELL: 46.0 ft. ELEVATION: ft.
 Depth(s) Groundwater Encountered 1. 38.0 ft. 2. ft. 3. ft.
 WELL'S STATIC WATER LEVEL: 36.52 ft. below land surface measured on mo/day/yr 11-17-94
 Pump test data: Well water was ft. after hours pumping gpm
 Est. Yield gpm: Well water was ft. after hours pumping gpm
 Bore Hole Diameter: 8.625 in. to 46.0 ft., and in. to ft.
 WELL WATER TO BE USED AS:
 5 Public water supply 8 Air conditioning 11 Injection well
 1 Domestic 3 Feedlot 6 Oil field water supply 9 Dewatering 12 Other (Specify below)
 2 Irrigation 4 Industrial 7 Lawn and garden only 10 Monitoring well MW-3
 Was a chemical/bacteriological sample submitted to Department? Yes No X; If yes, mo/day/yr sample was submitted
 Water Well Disinfected? Yes No X

5 TYPE OF BLANK CASING USED:
 1 Steel 3 RMP (SR) 5 Wrought iron 8 Concrete tile CASING JOINTS: Glued Clamped
2 PVC 4 ABS 6 Asbestos-Cement 9 Other (specify below) Welded
 7 Fiberglass Threaded X
 Blank casing diameter 2 in. to 30.75 ft., Dia. in. to ft., Dia. in. to ft.
 Casing height above land surface 0 (Flush) in., weight Sch. 40 lbs./ft. Wall thickness or gauge No.
 TYPE OF SCREEN OR PERFORATION MATERIAL:
2 PVC 10 Asbestos-cement
 1 Steel 3 Stainless steel 5 Fiberglass 8 RMP (SR) 11 Other (specify)
 2 Brass 4 Galvanized steel 6 Concrete tile 9 ABS 12 None used (open hole)
 SCREEN OR PERFORATION OPENINGS ARE:
 5 Gauzed wrapped 8 Saw cut 11 None (open hole)
 1 Continuous slot 3 Mill slot 6 Wire wrapped 9 Drilled holes
 2 Louvered shutter 4 Key punched 7 Torch cut 10 Other (specify)
 SCREEN-PERFORATED INTERVALS: From 30.75 ft. to 45.75 ft., From ft. to ft., From ft. to ft.
 SAND GRAVEL PACK INTERVALS: From 28 ft. to 46 ft., From ft. to ft., From ft. to ft.

6 GROUT MATERIAL: 1 Neat cement 2 Cement grout 3 Bentonite 4 Other
 Grout Intervals: From 0 ft. to 26 ft., From 26 ft. to 28 ft., From ft. to ft.
 What is the nearest source of possible contamination:
 1 Septic tank 4 Lateral lines 7 Pit privy 10 Livestock pens 14 Abandoned water well
 2 Sewer lines 5 Cess pool 8 Sewage lagoon 11 Fuel storage 15 Oil well/Gas well
 3 Watertight sewer lines 6 Seepage pit 9 Feedyard 12 Fertilizer storage 16 Other (specify below)
Contaminated site
 Direction from well? How many feet?

FROM	TO	LITHOLOGIC LOG	FROM	TO	PLUGGING INTERVALS
0	0.5'	Concrete			
0.5'	38.0	Silty clay			
38.0	40.3	Limestone gravel + sand			
40.3	42.0	Silty clay			
42.0	45.5	Sandy gravel			
45.5	46.0	Silty clay			
46.0	TD				
FLUSH MOUNT WAIVER 09-26-94 DON TAYLOR					

7 CONTRACTOR'S OR LANDOWNER'S CERTIFICATION: This water well was (1) constructed, (2) reconstructed, or (3) plugged under my jurisdiction and was completed on (mo/day/year) 10-19-94 and this record is true to the best of my knowledge and belief. Kansas Water Well Contractor's License No. 479 This Water Well Record was completed on (mo/day/yr) 11-21-94 under the business name of EBBERTS DRILLING by (signature) Suzan Elbert